

C 18

HINDS

MISSISSIPPI BOARD OF WATER COMMISSIONERS

C

11-18-60

WATER WELL DRILLERS LOG

EODER 300

Date: 11-18, 1960, Driller: James McNeese, County Hinds


531 ORIOLE DRIVE JACKSON

(1) Owner of Land: State
 (Name)
Friends of Alcoholics
 (Address)
 (2) Location: SW 1/4, NE 1/4, Sec. 16 T17 R14
1 1/2 miles South of Peachtree
 (distance) (direction) (Nearest Town)
 (3) Topography: Level
 (Hilly) (Flat) (Level)
 (4) Purpose of Well: Domestic
 (Domestic Irrigation, Municipal, Industrial, Other)

Description & Color of Materials Sand, Clay, Red Clay, Shell, etc.	Thick- ness Feet	Depth Feet
0-20 Surface soil	20	20
Grey shale	200	220
Grey sandy shale	263	483
Grey shale sand streaks	16	499
Grey sand	41	540
Grey sand shale streaks	140	680
Grey shale	25	705
Grey sandy shale, lignite	20	725
Grey shale, sand streaks	88	813

Information upon completion of well:

(1) Diameter 4 1/2 inches.
 (2) Total Depth 813 feet.
 (3) Water Level 80 feet below top of ground.
 (4) Cased to 520, Size 2 1/2"
 (5) Screen: Size 2 1/2", Length 20'
 (6) Were any formations sealed against pollution?
 _____ yes, ✓ no.
 If YES depth of formation _____
 Why _____
 Drillers Remarks: _____

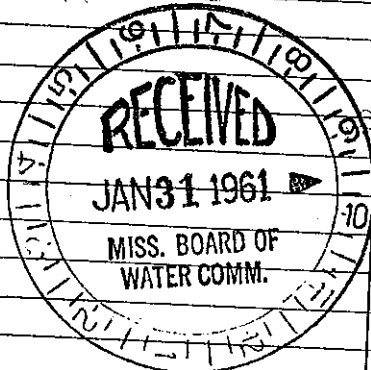

Well No.

(Use Back Side)

Mail this copy to Board of Water Commissioners 429 Miss. St. Jackson, Miss