

Hinds
C 22
6-66

MISSISSIPPI BOARD OF WATER COMMISSIONERS

ELOG # 247

Electricity Log by M.G. SCODES
WATER WELL DRILLERS LOG

Date: 6-1-66, Drillers: James M. Nees, County: Hinds
E Log 247 (Name)


(1) Owner of Land: D. T. Reed Construction Co
(Name)
JACKSON MISS
(Address)
(2) Location: S.E. 1/4, 36 17^N R1^W
4 miles N of JACKSON
(distance) (direction) (Nearest Town)
(3) Topography: (Hilly) (Flat) (Level)
(4) Purpose of Well: Domestic
(Domestic Irrigation, Municipal, Industrial, Other)

Description & Color of Materials Sand, Clay, Red Clay, Shell, etc.	Thick- ness Feet	Depth Feet
Clay	20	20
Grey shale	300	320
Grey Green sdy sh	26	346
Grey shale	98	444
Grey sh. lignite	42	486
SAND-sh. STRS	29	515
SZND	31	546
SAND-sh STRS	40	586
SAND	52	638
Grey sh	30	668

Information upon completion of well:

(1) Diameter: 4 X 2 1/2 inches.
(2) Total Depth: 668 feet.
(3) Water Level: 174 feet below top of ground.
(4) Cased to: 593, Size: 4" X 2 1/2"
(5) Screen: Size: 2 1/2, Length: 40
(6) Were any formations sealed against pollution?
_____ yes, no.
If YES depth of formation _____
Why _____
Drillers Remarks: water white

16 Jts 4"	338	
1-4" X 2 1/2 SWEDGE	1	
12 Jts 2 1/2	339	
	254	
	593	
4-2 1/2-10" SS SCREEN		
.007 .007 .008 .008	40	
TOP	633	
1-Jt. 2 1/2" @ B.P.V.	8	
	641	

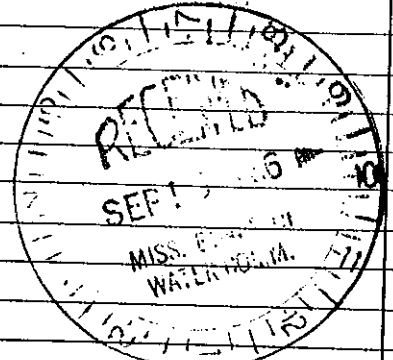

(Use Back Side)

Well No.