


Hinds
C23
7-66

MISSISSIPPI BOARD OF WATER COMMISSIONERS E LOG # 25
Electrical Log by M.G.S
WATER WELL DRILLERS LOG CODED

Date: 7-15-1966, Driller: James McNeas County Hinds
E Log 254 (Name)

	Description & Color of Materials Sand, Clay, Red Clay, Shell, etc.	Thick- ness Feet	Depth Feet
(1) Owner of Land: <u>F. O. Rees</u>			
(Name)			
<u>R.F.D. 2 JACKSON</u>	<u>SURFACE SOIL</u>	<u>20</u>	<u>20</u>
(Address)	<u>SAND</u>	<u>20</u>	<u>40</u>
(2) Location: <u>SE 1/4, SW 1/4, Sec. 10 T1 R1</u>	<u>SAND & shale</u>	<u>20</u>	<u>60</u>
<u>2</u> miles <u>south</u> of <u>Parhontes</u>	<u>Grey shale</u>	<u>340</u>	<u>400</u>
(distance) (direction) (Nearest Town)	<u>Grey green sdy sh</u>	<u>40</u>	<u>440</u>
(3) Topography: <input checked="" type="checkbox"/> (Hilly) <input type="checkbox"/> (Flat) <input type="checkbox"/> (Level)	<u>Grey sh</u>	<u>24</u>	<u>464</u>
(4) Purpose of Well: <u>Domestic Home</u>	<u>Grey sdy sh</u>	<u>19</u>	<u>483</u>
(Domestic Irrigation Municipal, Industrial, Other)	<u>Grey shale</u>	<u>62</u>	<u>545</u>
Information upon completion of well:	<u>Grey sh sd stks</u>	<u>33</u>	<u>578</u>
(1) Diameter <u>4" x 2"</u> inches.	<u>SAND</u>	<u>199</u>	<u>777</u>
(2) Total Depth <u>787</u> feet.	<u>Grey shale</u>	<u>10</u>	<u>787</u>
(3) Water Level <u>87'</u> feet below top of ground.			
(4) Cased to <u>750'</u> , Size <u>4" x 2"</u>	<u>16 fts 4"</u>	<u>337</u>	
(5) Screen: Size <u>2" 008</u> , Length <u>20</u>	<u>1 4" x 2" Swedge</u>	<u>1</u>	
(6) Were any formations sealed against pollution?	<u>20 fts 2"</u>	<u>338</u>	
_____ yes, <input checked="" type="checkbox"/> no.	<u>2-2" 008 ss</u>	<u>412</u>	
If YES depth of formation _____	<u>1 ft 2" B.P.V.</u>	<u>750</u>	
Why _____		<u>20</u>	
Drillers Remarks: <u>Water white</u>		<u>710</u>	
		<u>10</u>	
		<u>780</u>	

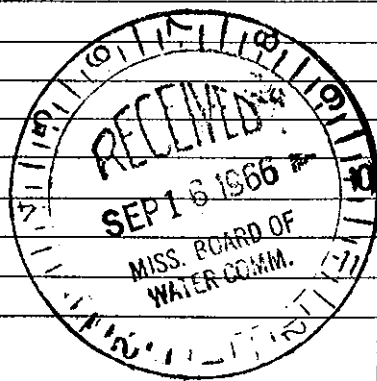

(Use Back Side)

Well No.

Mail this copy to Board of Water Commissioners 429 Miss. St. Jackson, Miss