

MISSISSIPPI
BOARD OF WATER COMMISSIONERS
416 North State Street
Jackson, Mississippi 39201

Loc # 280

WATER WELL DRILLERS LOG

Hinds
C-24
11-67
Elec. Log

date well completed 1967 Forest Drilling firm name Hinds county well located


LANDOWNER: Miss. Hwy. Dept - Jackson, Miss
(mailing address)

WELL LOCATION:
sec. 10 T. 7 N. R. 1 E.
POCAPHONTAS
miles HWY 49 of POCAPHONTAS
(distance) (direction) (nearest town)

WELL PURPOSE: Roadside PK.
(home, irrigation, municipal, industrial)

WELL COMPLETION DATA:
(1) diameter (inches) 4" x 2"
(2) total depth (feet) 776'
(3) static water level (feet) 93' below top of ground.
(4) casing Steel 756' (material) (depth)
3 7/8" - 1"
3 7/8" - 2" if telescope see back. (size)
(5) screen 20' (length) 756' (depth to top)
2" (size) 3/8" steel (material)
(6) pump 1 (sub) (HP) 12 (yield gpm)
220V (type power)
(7) electric log yes (yes or no)
V. D. Beal (organization running log)
(8) how well bottom plugged 2"
R/WASH VALVE

description of formations encountered	from	to
Brown Clay	0	18
Sand + Gravel		21
Clay + Silty Sand		39
Blue Clay		202
Sand + Silty Clay		262
Clay + Silt		302
Sand + Clay		322
Shale, soft		382
Shale		417
Sandy Shale		447
Sand + Silty Sand		462
Soft Shale		522
Silt + Silt		598
Sand + Silty Shale		622
Soft Shale + Silt		642
Silt		663
Silt + Shale		683
Shale		704
Shale + Silty Sand		714
Thin Sand		724
Thin Sand		780

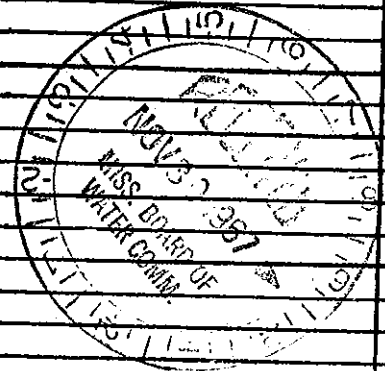

DRILLERS REMARKS: