

HINDS
 C 25
 11-6-68
 U.S.G.S.
 11-6-68

MISSISSIPPI
 BOARD OF WATER COMMISSIONERS
 416 North State Street
 Jackson, Mississippi 39201

CODED

WATER WELL DRILLERS LOG

James D McNeas Hinds

date well completed

firm name

county well located

LANDOWNER:
 Walter DENNIS
 JACKSON MISS
 (mailing address)

description of formations encountered	from	to
SURFACE soil	0	10
CLAY	10	40
Grey-Blue shale	40	100
Grey shale	100	153
Grey-Green sdy sh	153	219
Grey sdy sh	219	288
Grey sh	288	362
SAND	362	600
Grey sh	600	613


WELL LOCATION:
 sec 20 T 7 N R 1 E
 10 miles North of JACKSON
 (distance) (direction) (nearest town)

WELL PURPOSE: HOME
 (home, irrigation, municipal, industrial)

WELL COMPLETION DATA:

(1) diameter (inches) 4" x 2"
 (2) total depth (feet) 613
 (3) static water level (feet) 126 below top of ground.
 (4) casing steel 584' (material) (depth)
 (size) if telescope see back.
 (5) screen 15' 584' (length) (depth to top)
 2.008 stainless steel (size) (material)
 (6) pump 1 12 (HP) (yield gpm)
 Elec (type power)
 (7) electric log yes (yes or no)
 U.S.G.S. (organization running log)
 (8) how well bottom plugged mod

16 lbs 4" 2nd
 4x2 swedge 318
 12 lbs 2" 246
 2.008 ss screen 584
 2" Tail Pipe 2nd 599
 Back Wash Valve 6
 CODED 605

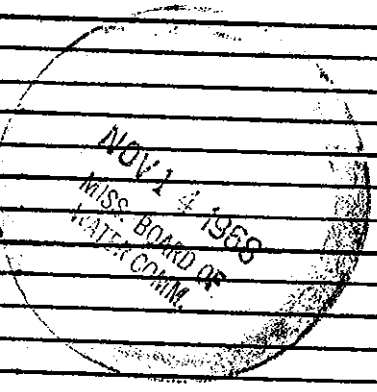

DRILLERS REMARKS:
 Water does not have color