

State Well Report

Part 1

Mississippi Department of Environmental Quality
 Office of Land and Water Resources
 P.O. Box 10631
 Jackson, MS 39289-0631
 (601)961-5210
 (601)354-6938 (fax)

For Office Use Only:

Aquifer: _____
 Well #: C-74
 L. S. Elevation: _____
 E-log #: _____

County: Hinds
 Permit #: 4" well
 Driller: Water well service
 Date drilling completed: 1-21-05

State Law requires that this report be prepared by the driller in detail and filed with the Department within 30 days of completion of drilling of the well.

Well Owner Information	Well Location
Owner Name: <u>Charles Anderson</u>	Latitude: <u>32° 26' 02"</u> Longitude: <u>90° 16' 20"</u>
Mailing Address: <u>138 Lorman Lane</u>	Method of Lat/Long (circle one): Conventional Survey, <input checked="" type="checkbox"/> USGS quad, <input checked="" type="checkbox"/> Hand-held GPS, <input checked="" type="checkbox"/> Survey-grade GPS
<u>Madison Ms 39110</u>	USGS quad: <u>NE 1/4 SW 1/4 Sec 23 Twn 7N Rng 1W</u>
City: _____ State: _____ Zip Code: _____	Distance: <u>6</u> Miles Direction: <u>N</u> of Nearest Town: <u>JACKSON</u>
Telephone No.: <u>(601) 853-7070</u>	

Well Data

Purpose of Well (circle one): Home Industrial Public Supply Irrigation Fish Culture Other: _____

Date well drilling started: 1-10-05 Date well drilling completed: 1-21-05

If flowing, method of flow regulation: Valve _____ Other (describe): _____

Static Water Level: 206 feet above or below (circle one) land surface Date measured: 1-20-05

Method of Measurement (circle one): steel tape electric tape air line other: _____

Hole depth: 590 Well depth: 580 Well grouted to a depth of 40 feet

Type of grout (circle one): Cement Bentonite Mix

Casing length: 560 feet Casing diameter: 300' of 4" / 260' of 3" inches Type of casing: PUC

Screen length: 20 feet Screen diameter: 3" inches Type of screen: PUC

Screen slot size: 0.08 inches Setting depth: From 560 feet to 580 feet

Type of completion (circle all applicable): Gravel packed Underreamed Telescoped Open hole Natural Development

Other (describe): _____

Top of lap pipe or reduction in casing: 300 feet. If telescoped or more than one screen, describe on back of page

Logs run (circle all applicable): No log run Electric Gamma Ray Density Sonic Neutron Other: _____

Name of organization running log(s): State Logger # C-0074

I certify that the well was drilled, constructed, and completed in accordance with all applicable requirements of the Mississippi Department of Environmental Quality and/or the Mississippi Department of Health regulations and state laws.

Arnold Fincher Sr 0598 Arnold Fincher Sr
 Print Name of Water Well Contractor and License No. Signature of Water Well Contractor

RECEIVED
FEB 02 2005
BY: OLWR

1. The first part of the document discusses the importance of maintaining accurate records of all transactions. This is essential for ensuring the integrity of the financial data and for providing a clear audit trail. The records should be kept up-to-date and should be easily accessible to all relevant parties.

2. The second part of the document outlines the procedures for handling any discrepancies or errors that may arise. It is important to identify the source of the error as soon as possible and to take appropriate corrective action. This may involve reviewing the original documents and consulting with the relevant staff members.

3. The third part of the document describes the process for reconciling the accounts. This involves comparing the internal records with the external statements and ensuring that they agree. Any differences should be investigated and explained.

4. The fourth part of the document discusses the role of the internal audit function. This is to provide an independent and objective assessment of the internal controls and to ensure that they are effective. The internal audit function should report to the board of directors and should have access to all relevant information.

5. The fifth part of the document outlines the requirements for the financial statements. These should be prepared in accordance with the relevant accounting standards and should be audited by an independent external auditor. The financial statements should provide a true and fair view of the financial position of the organization.

6. The sixth part of the document discusses the importance of transparency and accountability. This involves providing clear and concise information to all stakeholders and ensuring that the organization is held accountable for its actions.

7. The seventh part of the document outlines the process for managing risk. This involves identifying the risks that the organization faces and taking steps to mitigate them. This may involve implementing internal controls and monitoring the risks on an ongoing basis.

8. The eighth part of the document discusses the importance of continuous improvement. This involves regularly reviewing the internal controls and making changes as needed to ensure that they remain effective. This may involve seeking feedback from staff members and external stakeholders.

9. The ninth part of the document outlines the requirements for the annual financial statements. These should be prepared in accordance with the relevant accounting standards and should be audited by an independent external auditor. The financial statements should provide a true and fair view of the financial position of the organization.

10. The tenth part of the document discusses the importance of communication. This involves providing clear and concise information to all stakeholders and ensuring that the organization is held accountable for its actions.


11. The eleventh part of the document outlines the process for managing risk. This involves identifying the risks that the organization faces and taking steps to mitigate them. This may involve implementing internal controls and monitoring the risks on an ongoing basis.

12. The twelfth part of the document discusses the importance of continuous improvement. This involves regularly reviewing the internal controls and making changes as needed to ensure that they remain effective. This may involve seeking feedback from staff members and external stakeholders.

13. The thirteenth part of the document outlines the requirements for the annual financial statements. These should be prepared in accordance with the relevant accounting standards and should be audited by an independent external auditor. The financial statements should provide a true and fair view of the financial position of the organization.

If well telescopes please sketch below and show depths.


Ground Level **C-74**

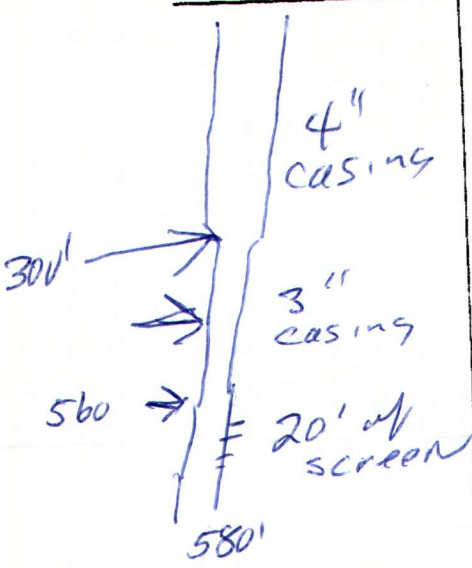

Description of Formations Encountered	From	To
Surface Sand & clay	0	70
Yazzo clay	70	390
Sand	390	410
Sandy clay	410	560
Sand	560	580

If more than one screen, show location of each on sketch

Sketch the property layout and include the following: 1) the well location; 2) any permanent structures on the property that may aid in locating the well; 3) any roads, power lines, or other items that may aid in locating the property and the well; 4) indicate direction.

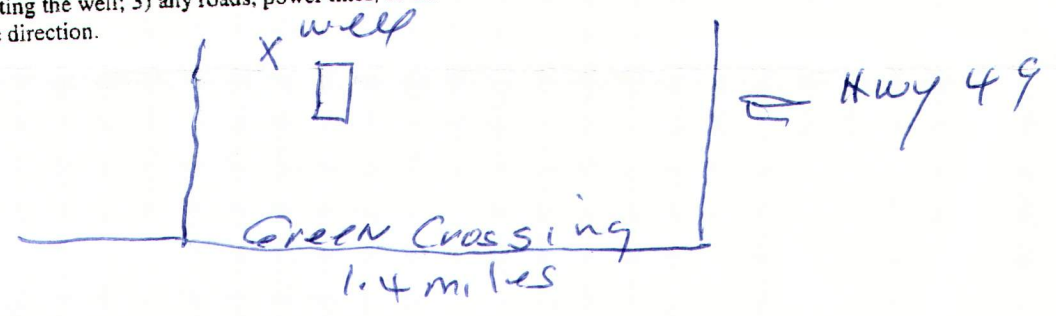

Landowner Name: Charles Anderson

Wald J. Smith Sr
Signature of Water Well Contractor

RECEIVED
FEB 02 2005
BY: OLWR

STATE OF TEXAS

007
118

THE STATE OF TEXAS
COUNTY OF [illegible]

[illegible text]

[illegible text]

STATE WELL REPORT

Part 2

Pump Installer's Completion Report
 Mississippi Department of Environmental Quality
 Office of Land and Water Resources
 P.O. Box 10631
 Jackson, MS 39289-0631
 (601)961-5210
 (601)354-6938 (fax)

For Office Use Only:

Aquifer: _____
 Well #: C-74
 Elevation: _____

County: Hands
 Permit #: 4" well
 Driller: Water Well Service
 Date completed: 1-22-05

This report should be prepared by the pump installer in detail and filed with the Department within 30 days of the installation of pump.

Well Owner Information	Well Location
Owner Name: <u>Charles Anderson</u>	Latitude: <u>322602^N</u> Longitude: <u>901620^W</u>
Mailing Address: <u>138 Lorman Lane</u>	Method of Lat/Long (circle one): Conventional Survey,
<u>Madison Ms 39110</u>	USGS quad, Hand-held GPS, Survey-grade GPS
City State Zip Code	<u>NE 1/4 SW 1/4 Sec 23 Twn 7N Rng 1W</u>
Telephone No. <u>(601) 853-7070</u>	Distance Direction Nearest Town
	<u>6 Miles N of Jackson</u>

Pump Type Circle one	Power Type Circle one
Air Lift Jet <input type="radio"/> <u>Submersible</u>	Diesel Engine Gasoline Engine Natural Gas
Bucket Piston <input type="radio"/> Turbine <input type="radio"/>	<u>Electric Motor</u> Hand Tractor PTO
Centrifugal Rotary <input type="radio"/> Flowing Well <input type="radio"/>	Windmill Other (specify): _____
Other (specify): _____	Horse Power Rating of Motor: <u>1.0</u>
Date Pump Installed: <u>1-22-05</u>	Setting Depth: <u>300</u> feet
Rated Pump Capacity: <u>16</u> Gallons Per Minute	Number of Stages: <u>9</u>

Pump Test Data	Method of Measuring Water Level Circle one
Date Well Tested: <u>1-22-05</u>	Air Line <input type="radio"/> <u>Electric Measuring Line</u> Steel Tape
Static Water Level (A): <u>206</u> Feet Below Land Surface	Other (specify): _____
Pumping Water Level (B): <u>240</u> Feet Below Land Surface	For flowing well, measured shut in head: _____ feet
Drawdown [(B) - (A)]: <u>34</u> Feet Below Land Surface	Well yielded _____ GPM with a drawdown of _____ feet after _____ hours of pumping
Test Pumping Rate: <u>15</u> Gallons Per Minute	
Duration of Pump Test (minimum 4 hours): <u>5</u> hours	

I HEREBY CERTIFY that the above statements are true to the best of my knowledge.

Arnold Fincher Sr 0598 Arnold Fincher Sr
 Print Name of Pump Installer and License No. (if applicable) Signature of Pump Installer

RECEIVED

FEB 02 2005
 BY: OLWR