


C 7000
7-31-61

WATER WELL DRILLERS LOG

Bor C

Date: July 31, 1961, Driller: M. C. Ray County: Hinds

(1) Owner of Land:	Description & Color of Materials Sand, Clay, Red Clay, Shell, etc.	Thick- ness Feet	Depth Feet
E. P. Raloff (Name)	Red Sand	0	31
Clinton Marin (Address)	Red Sand	21	42
(2) Location: 1/4, 1/4, Sec. 15 T. 7N. 1W	Red Sand	42	63
9 miles N of Clinton (distance) (direction) (Nearest Town)	SAND	63	84
(3) Topography: <input checked="" type="checkbox"/> (Hilly) <input type="checkbox"/> (Flat) <input type="checkbox"/> (Level)	SAND	84	105
(4) Purpose of Well: Home (Domestic Irrigation, Municipal, Industrial, Other)	Blue Clay - SAND	105	126
Information upon completion of well:	Blue Clay	126	294
(1) Diameter: 2 1/2 x 2" inches.	Sea Shell Clay SAND	294	315
(2) Total Depth: 1008 feet.	Blue Clay	315	588
(3) Water level: 154 feet below top of ground.	Sandy SAND	588	609
(4) Cased to: 968, Size: 2"	SANDY clay	609	630
(5) Screen: Size 206, Length 40	Blue Clay	630	673
(6) Were any formations sealed against pollution? yes, <input type="checkbox"/> no, <input checked="" type="checkbox"/>	SANDY clay	673	694
If YES depth of formation	Rock - SANDY clay	694	714
Why	SANDY clay	714	861
Drillers Remarks:	Rock 23" SANDY	861	882
	SANDY clay	882	903
	FINE SAND	903	924
	SAND	924	945

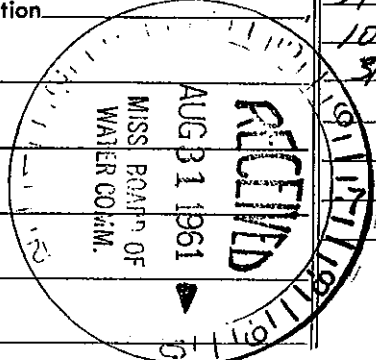

(Use Back Side)

Well No.