

HINDS
C 7001

8-62
8-1-62

MISSISSIPPI BOARD OF WATER COMMISSIONERS

629 check

WATER WELL DRILLERS LOG

Date: AUGUST, 1962, Driller: MENECE DRILLING Co County HINDS

(Name)

(1) Owner of Land: DR & MRS S. REYNOLDS
(Name)

RT. 2 Box 252 JACKSON MISS
(Address)

(2) Location: 1/4, NE 1/4, Sec. 21 T7N R1W

2 miles SOUTH of POCAHONTAS
(distance) (direction) (Nearest Town)

(3) Topography: FLAT
(Hilly) (Flat) (Level)

(4) Purpose of Well: DOMESTIC use
(Domestic Irrigation
Municipal, Industrial, Other)

Description & Color of Materials
Sand, Clay, Red Clay, Shell, etc.

Thick-
ness
Feet

Depth
Feet

Description & Color of Materials Sand, Clay, Red Clay, Shell, etc.	Thick- ness Feet	Depth Feet
SURFACE SOIL	12	12
YELLOW MARL	26	38
GREY SHALE	362	400
SHALE, SHELL & SAND	20	420
SHALE & LIGNITE	50	470
LIGNITE & FINE SAND	64	534
SHALE	22	556
SAND & SHALE	29	585
COARSE SAND	30	615

Information upon completion of well:

(1) Diameter 3' x 2" inches.

(2) Total Depth 615 feet.

(3) Water Level 100 feet below top of ground.
595

(4) Cased to 3/2", Size 3"
3 1/2' - 615' - 2"

(5) Screen: Size 2", Length 20'


(6) Were any formations sealed against pollution?

yes, no.

If YES depth of formation

Why

Drillers Remarks:

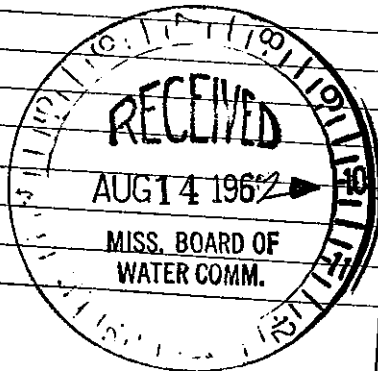

(Use Back Side)

Well No.
39

Mail this copy to Board of Water Commissioners 429 Miss. St. Jackson, Miss