

HINDS

C 7003


5-14-65

MISSISSIPPI BOARD OF WATER COMMISSIONERS

WATER WELL DRILLERS LOG

Date: 5/14, 1965, Driller: M Kay County Humboldt

(1) Owner of Land: <u>W. G. Maller</u> (Name)	Description & Color of Materials Sand, Clay, Red Clay, Shell, etc.	Thick- ness Feet	Depth Feet
<u>4102 Cedar St Jackson</u> (Address)	Red clay	0	20
(2) Location: <u>1/4, 1/4, Sec. T. 12 R. 1 W.</u>	White Chalk	20	40
<u>3</u> miles <u>N</u> of <u>Clinton</u> (distance) (direction) (Nearest Town)	Blue Clay	40	320
(3) Topography: <input checked="" type="checkbox"/> (Hilly) <input type="checkbox"/> (Flat) <input type="checkbox"/> (Level)	Sandy Shale	320	360
(4) Purpose of Well: <u>Home</u> (Domestic Irrigation, Municipal, Industrial, Other)	Shale	360	650
Information upon completion of well:	Sandy Shale	650	720
(1) Diameter <u>2</u> inches.	Fined Sand	720	730
(2) Total Depth <u>1295</u> feet.	Hard Shale	730	794
(3) Water Level <u>88</u> feet below top of ground.	Sand - Clay Str.	794	840
(4) Cased to <u>1965</u> , Size _____	Blue Shale	840	980
(5) Screen: Size <u>007</u> , Length <u>30</u>	" - Rock	980	1000
(6) Were any formations sealed against pollution? _____ yes, <input checked="" type="checkbox"/> no.	Hard Shale	1000	1020
If YES depth of formation _____	" "	1020	1040
Why _____	" - 14" Rock	1040	1060
Drillers Remarks: _____	Sandy Shale	1060	1120
_____	" "	1120	1230
_____	Med Sand	1230	1295

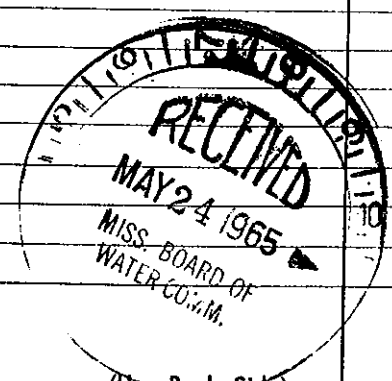

(Use Back Side)

Well No.

Mail this copy to Board of Water Commissioners 429 Miss. St. Jackson, Miss