

HINDS

MISSISSIPPI BOARD OF WATER COMMISSIONERS

C 2004 Electrical Log Miss Geological Survey


11-23-65

WATER WELL DRILLERS LOG

Date: 11-23, 1965, Driller: James McNeas County Hinds

(Name)

(1) Owner of Land: <u>Thomas Patterson</u> (Name)	Description & Color of Materials Sand, Clay, Red Clay, Shell, etc.	Thick- ness Feet	Depth Feet
<u>JACKSON MISS</u> (Address)	SURFACE soil	5	5
(2) Location: <u>SE 1/4, N. W. 1/4, Sec. 27 N. T. 7 R. 1 W.</u> <u>6</u> miles <u>N.W.</u> , of <u>JACKSON</u> (distance) (direction) (Nearest Town)	CLAY	18	23
(3) Topography: <input checked="" type="checkbox"/> (Hilly) <input type="checkbox"/> (Flat) <input type="checkbox"/> (Level)	Blue shale	410	433
(4) Purpose of Well: <u>Domestic (house)</u> (Domestic Irrigation, Municipal, Industrial, Other)	Grey sdy sh	27	460
Information upon completion of well:	Grey shale	32	492
(1) Diameter <u>4" x 2 1/2"</u> inches. <u>40'</u>	Grey sdy sh	102	594
(2) Total Depth <u>754</u> feet.	SAND sh STKS	41	635
(3) Water Level <u>204</u> feet below top of ground.	SAND	41	676
(4) Cased to <u>608</u> <sup>724</sup> , Size <u>4" x 2 1/2"</u> <sup>4"</sup>	Grey sdy sh	49	725
(5) Screen: Size <u>2 1/2" 008</u> , Length <u>30</u>	SAND	12	737
(6) Were any formations sealed against pollution? <input type="checkbox"/> yes, <input checked="" type="checkbox"/> no.	Grey sdy sh	17	754
If YES depth of formation _____	16 JTS 4"	334	
Why _____	1- 4" x 2 1/2" swagoc	1	
Drillers Remarks: <u>White Water</u>	13 JTS 2 1/2"	335	
	3. 2 1/2" x 10' .008 SSS	30	608
	1-JT 2 1/2" with BPV	15	638
			653

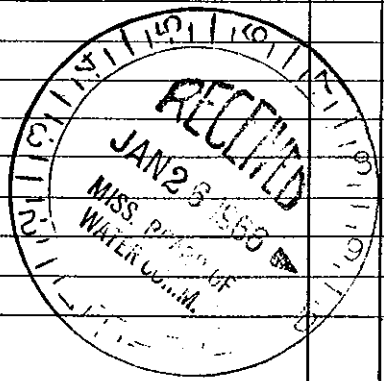

(Use Back Side)

Well No.

Mail this copy to Board of Water Commissioners 429 Miss. St. Jackson, Miss.