

HINDS

MISSISSIPPI BOARD OF WATER COMMISSIONERS

D ~~3000~~

8-30-60
8/24 to

WATER WELL DRILLERS LOG

D 300

Forest Drilling

Date: 8/30, 1960, Driller: Johnnie Beasley County Hinds.

(Name)

(1) Owner of Land: M. N. Warren
(Name)
Rt. 1, Edwards, Miss.
(Address)

(2) Location: 1/4, 1/4, Sec. T R
8 miles North of Edwards
(distance) (direction) (Nearest Town)

(3) Topography: X
(Hilly) (Flat) (Level)

(4) Purpose of Well: Domestic.
(Domestic Irrigation
Municipal, Industrial, Other)

Description & Color of Materials Sand, Clay, Red Clay, Shell, etc.	Thick- ness Feet	Depth Feet
Brown Silt.	0	18
Chalk.	18	47
Blue Clay.	47	115
Shell, Lime & Clay.	115	145
Rock & Stks. Clay.	145	200
Shale & Muck.	200	273
Blue Clay.	273	478
Shale & Lime.	478	663
Shale.	663	831
Soft Shale.	831	851
Shale & Mucky Sand.	851	877
Shale.	877	903
Shale & Stks. Muck.	903	934
Shale & Stks. Rock.	934	954
Hard Shale.	954	980
Shale, Stks. Silt & Shell.	980	1010
Hard Shale.	1010	1051
Shale & Stks. Sand. (20' Screen set here)	1051	1075
Shale.	1075	1123
Sandy Morral.	1123	1236
Shale & Stks. Silt.	1236	1246
Shale.	1246	1270

Information upon completion of well:

(1) Diameter 2 inches.

(2) Total Depth 1075 feet.

(3) Water Level 175 feet below top of ground.

(4) Cased to 1055', Size 2"


(5) Screen: Size 2", Length 20'

(6) Were any formations sealed against pollution?
yes, X no.

If YES depth of formation _____

Why _____

Drillers Remarks: Good well.

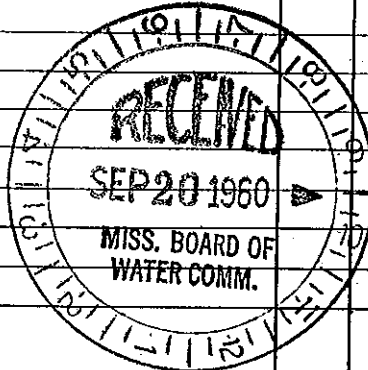

Well No.

(Use Back Side)

Mail this copy to Board of Water Commissioners 429 Miss. St. Jackson, Miss.