

WATER WELL DRILLERS LOG

D
1-23-64

Date: 1-23-1964, Driller: Layne-Central Co. County Hinds

(Name)

(1) Owner of Land: Adams Egg Company

(Name)

Edwards, Mississippi

(Address)

(2) Location: 1/4, 1/4, Sec. T R

miles of
(distance) (direction) (Nearest Town)

(3) Topography:

(Hilly) (Flat) (Level)

(4) Purpose of Well: Egg Farm

(Domestic Irrigation
Municipal, Industrial, Other)

Information upon completion of well:

(1) Diameter 8" inches.

(2) Total Depth 1053' feet.

(3) Water Level 50 feet below top of ground.

(4) Cased to 1001', Size 8"

(5) Screen: Size 6", Length 40'

(6) Were any formations sealed against pollution?


x yes, no.

If YES depth of formation 1001'

Why required

Drillers Remarks:

Description & Color of Materials Sand, Clay, Red Clay, Shell, etc.	Thick- ness Feet	Depth Feet
soil	2	0
sandy clay	8	10
clay gravel	11	21
rock	4	25
clay	11	36
clay-rock stks.	49	85
clay-stks fine sand	55	140
fine sand-stks clay	52	192
hard brittle clay	120	312
blue clay	386	698
rock-soft stks.	5	703
hard shale	15	718
shale	59	777
shale-stks sand	18	795
rock	1	796
shale-hard soft stks	51	847
shale (brown)	33	880
sandy shale	15	895
fine sand	158	1053

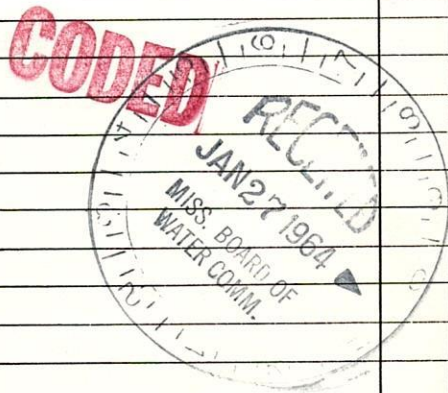

(Use Back Side)

Well No.

HINDS

D
2-14-64

WATER WELL DRILLERS LOG

J27

Date: 2-14-64, 19___, Driller: Layne-Central Co. County Hinds (Name)

- (1) Owner of Land: Adams Egg Company
(Name)
Edwards, Mississippi
(Address)
- (2) Location: ___ 1/4, ___ 1/4, Sec. ___ T ___ R ___
___ miles ___ of ___
(distance) (direction) (Nearest Town)
- (3) Topography: ___
(Hilly) (Flat) (Level)
- (4) Purpose of Well: Egg Processing
(Domestic Irrigation
Municipal, Industrial, Other)

Description & Color of Materials Sand, Clay, Red Clay, Shell, etc.	Thick- ness Feet	Depth Feet
soil	2	2
sandy clay	8	10
clay gravel	11	21
rock	4	25
clay	11	36
clay-rock streaked	49	85
clay-stks fine sand	55	140
fine sand-stks clay	52	192
hard brittle clay	120	312
blue clay	386	698
rock-soft stks	5	703
hard shale	15	718
shale	59	777
shale-stks sand	18	795
rock	1	796
shale-hard & soft stks	51	847
brown shale	33	880
sandy shale	15	895
fine sand	158	1053


Information upon completion of well:

- (1) Diameter 8 inches.
- (2) Total Depth 1053 feet. *Dug*
- (3) Water Level 50 feet below top of ground.
- (4) Cased to 1001', Size 8"
- (5) Screen: Size 6", Length 40'
- (6) Were any formations sealed against pollution?
 yes, ___ no.

If YES depth of formation 1001'
Why required

Drillers Remarks: _____

CODED

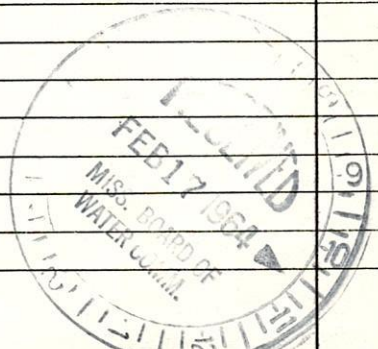

(Use Back Side)

Well No.