

E LOG # 280

MISSISSIPPI
BOARD OF WATER COMMISSIONERS
416 North State Street
Jackson, Mississippi 39201

CODED

WATER WELL DRILLERS LOG

Hinds
D14
9-67
Elec Log

9-27-67 date well completed
James D McNeas firm name
Hinds county well located

LANDOWNER: R. E. FLOYD

Edwards MISS

description of formations encountered

from to

Clay	0	50
ROCK	50	88
Grey sdy sh	88	101
Grey sh	101	175
Grey sdy sh	175	182
SEND	182	207
Grey sh	207	264

(mailing address)


WELL LOCATION:

sec. 4 T. 6 N R. 4 W
4 miles N of Edwards
(distance) (direction) (nearest town)

WELL PURPOSE: HOME
(home, irrigation, municipal, industrial)

WELL COMPLETION DATA:

- (1) diameter (inches) 4 x 2
- (2) total depth (feet) 264
- (3) static water level (feet) 69 below top of ground.
- (4) casing steel (material), 4 x 2 (depth) (size) if telescope see back.
- (5) screen 10 194 (length) (depth to top) stainless steel (size) (material)
- (6) pump 1 20 (HP) (yield gpm) Elec (type power)
- (7) electric log Yes (yes or no) M.C.S. (organization running log)
- (8) how well bottom plugged mud

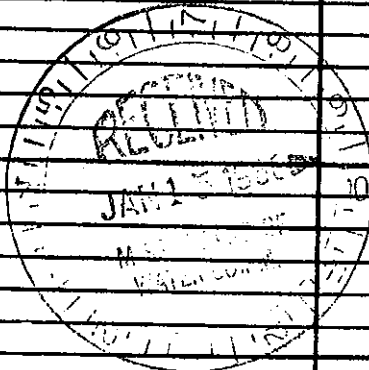

DRILLERS REMARKS:

Water clear