

ELOG # 284

Hinds
D20
12-67
Elec 204
12-13-67
date well completed

MISSISSIPPI
BOARD OF WATER COMMISSIONERS
416 North State Street
Jackson, Mississippi 39201

CODED

WATER WELL DRILLERS LOG

James D. McNeas
firm name

Hinds
county well located

LANDOWNER: Mt. Beulah College

description of formations encountered


Edwards MISS
(mailing address)
WELL LOCATION:
sec. 29 T. 6 N R. 4 W
1 miles west of Edwards
(distance) (direction) (nearest town)

description of formations encountered	from	to
SURFACE SOIL	0	10
CLAY	10	60
Blue shale	60	100
ROCK sh STKS	100	150
SAND sh	150	165
Grey sh sd STKS	165	263
Grey sh	263	790
SAND-ROCK STKS	790	805
SAND sh STKS	805	870
SAND Hard	870	885
SANDY sh	885	890
SAND Hard	890	930
Grey sdy sh	930	965
SAND	965	970
Grey sdy sh	970	1009
SAND	1009	1014
Grey sh sd STKS	1014	1045
SAND	1045	1066
Grey sh	1066	1080
SAND	1080	1114
SDY sh	1114	1123
SAND	1123	1147
Grey sh sd STKS	1147	1155
SAND	1155	1198
ROCK	1198	1199
sh sd STKS	1199	1333
SAND	1333	1362
Grey sh	1362	1375
Hard sh	1375	1396

WELL PURPOSE: College
(home, irrigation, municipal, industrial)

WELL COMPLETION DATA:

- (1) diameter (inches) 4 x 2 1/2
- (2) total depth (feet) 1396
- (3) static water level (feet) 84 below top of ground.
- (4) casing steel 1330'
(material) (depth)
4" x 2 1/2" if telescope see back.
(size)
- (5) screen 30' 1330
(length) (depth to top)
2 1/2" stainless steel
(size) (material)
- (6) pump 5 40
(HP) (yield gpm)
Elec
(type power)
- (7) electric log yes
(yes or no)
M.G.S.
(organization running log)
- (8) how well bottom plugged mud

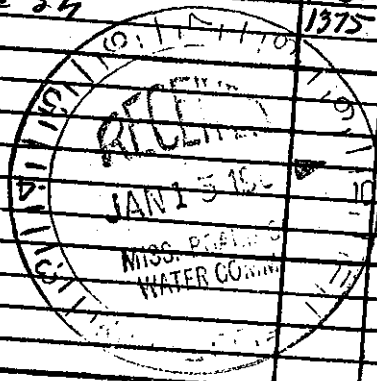

DRILLERS REMARKS:
Water has color