

Hinds
D24
12-18-74
E Log # 553

MISSISSIPPI
BOARD OF WATER COMMISSIONERS
416 North State Street
Jackson, Mississippi 39201

CODED

WATER WELL DRILLERS LOG


12-18-74 date well completed JACK Guinn firm name Hinds county well located

LANDOWNER:	description of formations encountered	from	to
BUCK ALLEN			
(mailing address)	Rock	160	205
WELL LOCATION:	Sand	205	214
sec. <u>10</u> T. <u>1</u> N. R. <u>1</u> E. W. <u>1</u>	CLAY	214	313
<u>1/2</u> miles S.W. of Edward	Sand	313	400
(distance) (direction) (nearest town)			

WELL PURPOSE:
(home, irrigation, municipal, industrial)

- WELL COMPLETION DATA:
- (1) diameter (inches) 4" x 2"
 - (2) total depth (feet) 374
 - (3) static water level (feet) 150 below top of ground.
 - (4) casing PVC. 364'
(material) (depth)
4" x 2"
(size) (if telescope see back.)
 - (5) screen 10' 364'
(length) (depth to top)
2" SS
(size) (material)
 - (6) pump 1 10
(HP) (yield gpm)
M.P.L.
(type power)
 - (7) electric log YES
(yes or no)
USGS
(organization running log)
 - (8) how well bottom plugged B.W.V.

CODED

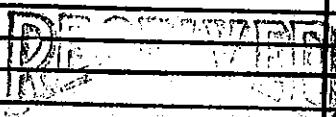

DEC 19 1974

BD. OF WATER COMM.

DRILLERS REMARKS: