

HINDS
D 26

MISSISSIPPI
BOARD OF WATER COMMISSIONERS
416 North State Street
Jackson, Mississippi 39201

WATER WELL DRILLERS LOG

~~2-26~~ 11-7-19 96
date well completed


LAYNE CENTRAL
firm name

county well located

LANDOWNER:	description of formations encountered	from	to
TOWN OF EDWARDS			
(mailing address)			
WELL LOCATION: sec <u>27</u> T <u>60</u> N S R <u>4</u> E W _____ miles _____ of _____ (distance) (direction) (nearest town)	<p>see attached</p>		
WELL PURPOSE: (home, irrigation, municipal, industrial)			
WELL COMPLETION DATA:			
(1) diameter (inches) <u>10 X 6"</u>			
(2) total depth (feet) <u>1206</u>			
(3) static water level (feet) <u>179</u> ^{below} _{above} top of ground.			
(4) casing <u>STEEL</u> (material), <u>1186</u> (depth)			
<u>10 X 6"</u> (size) if telescope see back.			
(5) screen <u>20</u> (length), <u>1186</u> (depth to top)			
<u>6</u> (size), <u>SS</u> (material)			
(6) pump <u>60</u> (HP), <u>351</u> (yield gpm)			
(type power)			
(7) electric log <u>YES</u> (yes or no)			
<u>LAYNE</u> (organization running log)			
(8) how well bottom plugged _____			
DRILLERS REMARKS:			

300gpm #65
351gpm 60hp

Log of Well for Town of Edwards Well No. 3
 Address (City) Edwards (County) Hinds State Mississippi
 Location of Well Behind Gulf Station Made in Test Hole No. 1

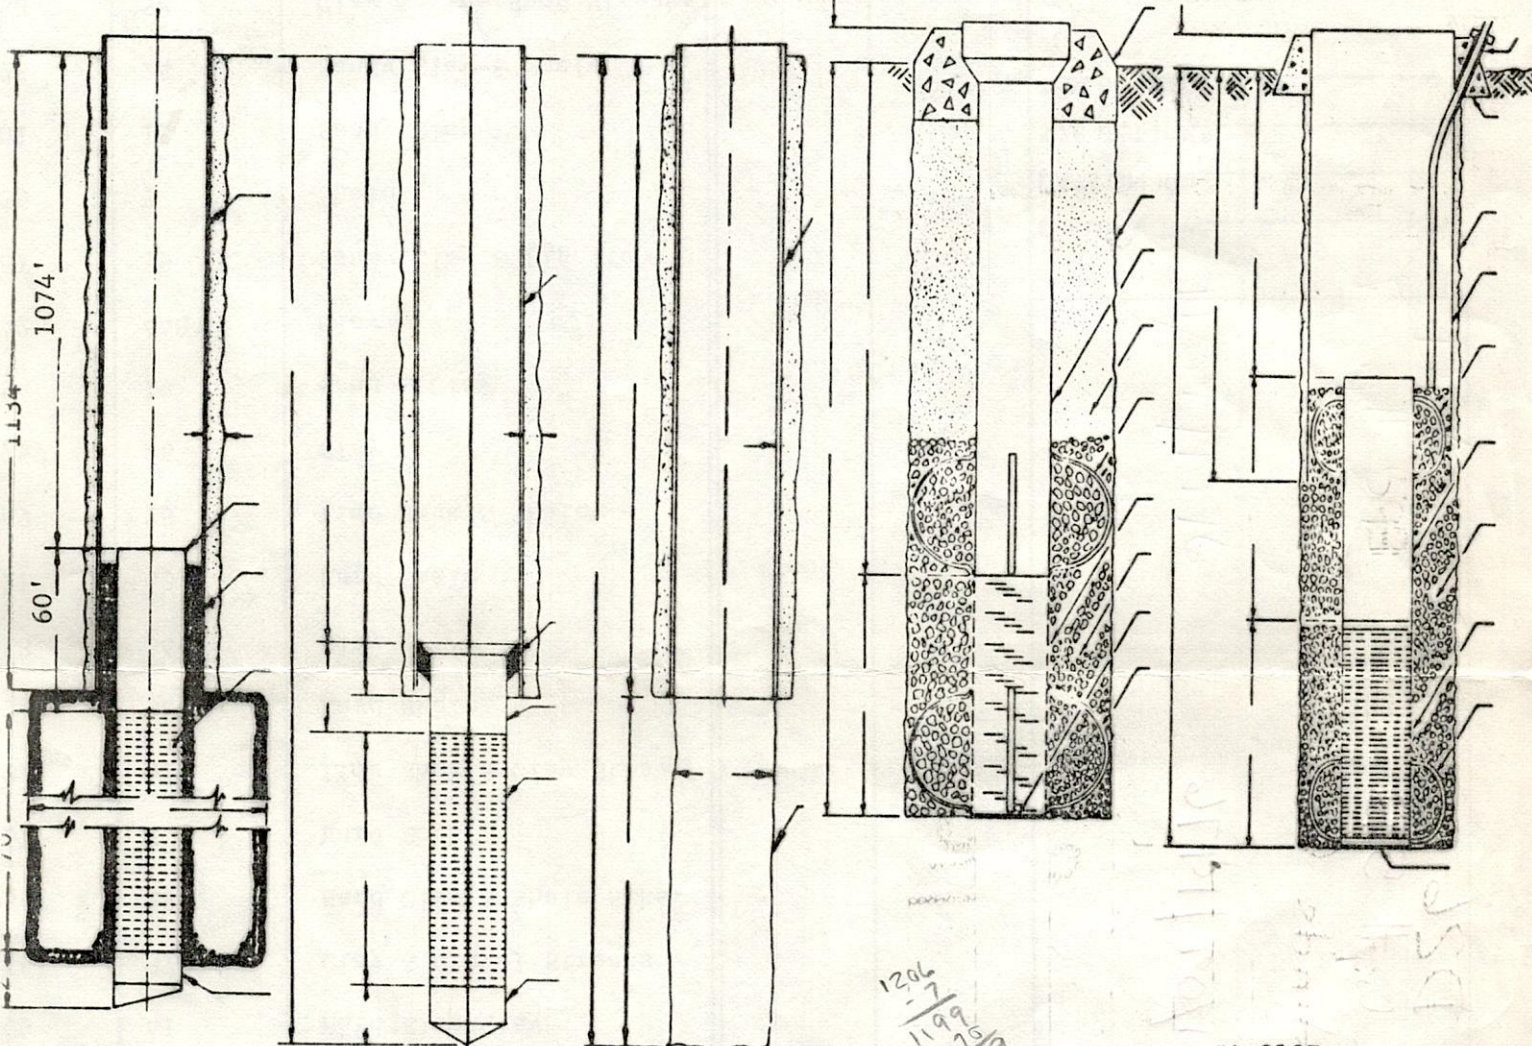

1206
- 77
1134
- 76
76

CONTRACT NO. JA-0127
 STARTED WELL 7-20 19 76 AND COMPLETED 11-7 19 76

TOTAL DEPTH 1206' ELEVATION STATIC WATER LEVEL 179'
 ALL MEASUREMENTS TAKEN FROM (GROUND) (TOP OF FOUNDATION) (TOP OF CASING) (TOP BASE PLATE)
 SURFACE CASING: SIZE _____ LENGTH _____ THICKNESS _____ T & C WELDED
 CEMENTED WITH _____ SACKS CEMENT OR PACKER TYPE _____
 WELL CASING: SIZE 10" LENGTH 1134' WEIGHT _____ T & C WELDED
 CEMENTED WITH Halliburton SACKS CEMENT 550 sx. OR PACKER TYPE _____
 INNER CASING SIZE 6" LENGTH 60' TYPE MATERIAL _____ T & C WELDED
 WITH 1 1/2 x 1 1/2 (GUIDES LOCATED) 1075' - 1130' TYPE BACKOFF _____
 SIZE SEAL _____ BACKPRESSURE VALVE SIZE 6" LENGTH GUIDE _____
 WELL STRAINER: MAKE Johnson TYPE WW SIZE 6" LENGTH 70' OPENING #12 slot
 TYPE MATERIAL Stainless Steel WITH CONNECTIONS _____
 SIZE HOLE DRILLED FOR SURFACE CASING _____ WITH _____ BIT
 SIZE HOLE DRILLED FOR WELL CASING 15" WITH Roller BIT
 SIZE HOLE DRILLED FOR STRAINER 26" WITH Underreamer REAMER
 YARDS OF GRAVEL USED 350 sx. HOW PLACED Tremie Line TYPE 20-40
 HOW WAS WELL DEVELOPED Agitator & Test Pump SAND? No CLEAR? Yes
 FOUNDATION INSTALLED NO _____ DEPTH FEELING RODS _____ TOP OF WELL _____



LAYNE - Central Company

NOTES: _____ RIG USED _____ SUPT. P. S. Weeks DRILLER Hartfield & Tune

RECEIVED

FEB 16 1978

MBS

DRILLED FOR Town of Edwards

ADDRESS Edwards, Mississippi

MISS. BD. OF WATER COMM

DATE 7-26-76

OF SEC. 27 TS 6N R 4W

COUNTY Hinds

CODED

TOTAL DEPTH	EACH STRATUM	FORMATION	TOTAL DEPTH	EACH STRATUM	FORMATION
15	15	Red Sandy Clay	1225	19	Shale & Sand Streaks
28	13	Hard Yellow Clay			
34	6	Clay & Sand Streaks			
68	34	Hard Shale			
109	41	Hard Blue Clay			
146	37	Clay & Gravel Streaks			
159	13	Hard Clay & Shale Stks.			
161	2	Hard Rock			
202	41	Lime Rock & Clay Stks.			
234	32	Hard Shale			
288	54	Clay			
321	43	Hard Shale			
349	28	Lime Rock & Shale			
375	26	Clay			
394	19	Sand & Clay			
842	448	Clay			
881	39	Sandy Clay & Lignite			
886	5	Shale			
901	15	Sandy Clay			
925	24	Sandy Clay & Shale			
983	58	Clay & Fine Sand Streaks			
984	1	Rock			
1030	46	Clay & Sand Streaks			
1076	46	Hard Clay			
1108	32	Sand & Shale Breaks			
1130	22	Shale & Hard Streaks			
1206	76	Fine Sand & Shale Breaks			

01/17/78
 Hinds Co.
 E Log # 598
 D26
 CODED
 11/07/1976

DRILLING TIME _____ HR.
 DAYS ON JOB _____
 SIZE TEST HOLE _____
 TYPE BIT USED _____

G.W.Hartfield & Charlie Tune
 DRILLER
 P. S. Weeks
 FIELD SUPT.

