

HINDS MISSISSIPPI BOARD OF WATER COMMISSIONERS

D 2001

WATER WELL DRILLERS LOG

Hinds

9-5-63

Date: 9/5, 1963, Driller: Faust W. G. Aut. County: ~~Scott~~


(Name)

(1) Owner of Land:	Description & Color of Materials Sand, Clay, Red Clay, Shell, etc.	Thick- ness Feet	Depth Feet
(Name) <u>Gray Flowers</u> (Address) <u>Edwards, Miss.</u>	<u>Brown silt</u>	<u>0</u>	<u>40</u>
(2) Location: _____ 1/4, _____ 1/4, Sec. <u>28 T. 6 N. R. 4 W.</u>	<u>yellow sand</u>		<u>60</u>
On Hwy 80 near <u>Prina</u> (distance) _____ miles (direction) _____ of _____ (Nearest Town)	<u>blue clay</u>		<u>80</u>
(3) Topography: _____ (Hilly) _____ (Flat) _____ (Level) _____	<u>blue clay</u>		<u>100</u>
(4) Purpose of Well: <u>Cattle</u> (Domestic Irrigation Municipal, Industrial, Other)			

Information upon completion of well:

- (1) Diameter 4 inches.
- (2) Total Depth 100 feet.
- (3) Water Level 43 feet below top of ground.
- (4) Cased to 85 Size 4" x 2"
- (5) Screen: Size 3", Length 15ft.
- (6) Were any formations sealed against pollution?  
 \_\_\_\_\_ yes, X no.

If YES depth of formation \_\_\_\_\_  
 Why \_\_\_\_\_  
 Drillers Remarks: \_\_\_\_\_

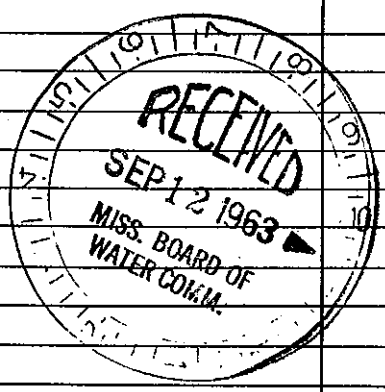

Well No.

(Use Back Side)

Mail this copy to Board of Water Commissioners 429 Miss. St. Jackson, Miss.