

HINDS MISSISSIPPI BOARD OF WATER COMMISSIONERS


D 7002

6-18-65

WATER WELL DRILLERS LOG

Date: 6/18, 1965, Driller: McKay County Hinds
(Name)

(1) Owner of Land:	Description & Color of Materials Sand, Clay, Red Clay, Shell, etc.	Thick- ness Feet	Depth Feet
<u>Jay Moore</u> <small>(Name)</small> <u>Edward M. Moore</u> <small>(Address)</small>	<u>Red Clay</u>	<u>0</u>	<u>20</u>
(2) Location: <u>1/4</u> , <u>1/4</u> , Sec. <u>31</u> T <u>6N</u> R <u>4W</u>	<u>White Chalk</u>	<u>20</u>	<u>40</u>
<u>3</u> miles <u>SW</u> , of <u>Edwards</u> <small>(distance) (direction) (Nearest Town)</small>	<u>Shale</u>	<u>40</u>	<u>150</u>
(3) Topography: <input checked="" type="checkbox"/> (Hilly) <input type="checkbox"/> (Flat) <input type="checkbox"/> (Level)	<u>Thin Rock</u>	<u>150</u>	<u>220</u>
(4) Purpose of Well: <u>Home</u> <small>(Domestic Irrigation Municipal, Industrial, Other)</small>	<u>Sandy Shale</u>	<u>220</u>	<u>300</u>
Information upon completion of well:	<u>1. 1. 1.</u>	<u>300</u>	<u>340</u>
(1) Diameter <u>2</u> inches.	<u>Fine Sand</u>	<u>340</u>	<u>360</u>
(2) Total Depth <u>1080</u> feet.	<u>Blue Clay</u>	<u>360</u>	<u>600</u>
(3) Water Level <u>122</u> feet below top of ground.	<u>Rock Str. Hard Shale</u>	<u>600</u>	<u>700</u>
(4) Cased to <u>1060</u> , Size _____	<u>1. 1. 1.</u>	<u>700</u>	<u>860</u>
(5) Screen: Size <u>007</u> , Length <u>20</u>	<u>Hard Rock</u>	<u>860</u>	<u>862</u>
(6) Were any formations sealed against pollution? _____ yes, <input checked="" type="checkbox"/> no.	<u>Blue Clay</u>	<u>862</u>	<u>980</u>
If YES depth of formation _____	<u>Sandy Shale</u>	<u>980</u>	<u>1040</u>
Why _____	<u>Med Sand (Good)</u>	<u>1040</u>	<u>1080</u>
Drillers Remarks: _____	<u>Set 2HP. Gould jet</u>		

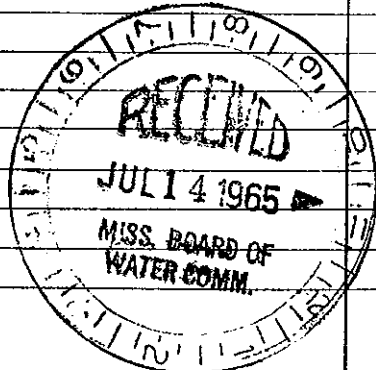

(Use Back Side)

Well No.

Mail this copy to Board of Water Commissioners 429 Miss. St. Jackson, Miss.