

Hinds
E 16
8-66

MISSISSIPPI BOARD OF WATER COMMISSIONERS
Electrical Log by M.C.S. ELOG #258
WATER WELL DRILLERS LOG CODED

Date: 8-31, 1966, Driller: James McNeese County Hinds

E Log 258

(Name)

(1) Owner of Land J.C. McBeath
(Name) Edwards Miss
(Address) SW 1/4 NE 1/4, Sec. 17 T6 R3
(2) Location: 5 miles East of Edwards
(distance) (direction) (Nearest Town)
(3) Topography: (Hilly) (Flat) (Level)
(4) Purpose of Well: Domestic
(Domestic Irrigation
Municipal, Industrial, Other)

Description & Color of Materials Sand, Clay, Red Clay, Shell, etc.	Thick- ness Feet	Depth Feet
SURFACE SOIL	10	10
CLAY	20	30
SAND	10	40
Grey sh - sd STKS	18	58
lime sh STKS	34	92
Grey sdy sh	98	190
Grey sh	581	771
Grey sdy sh	20	791
Grey sh sd STKS	106	897
Grey sh	20	917
—	29	946
Grey sdy sh	10	956
SAND	3	959
Grey sh sd STKS	22	986
SAND	41	1027
Grey sdy sh	13	1040
16 fts 4"	337	
1-4" x 2 1/2" swedge	1	
31 fts 2 1/2"	338	
3-10' 2 1/2" .008 sss	654	
	992	
	30	
1-ft. 2 1/2" with B.P.P.	1022	
	8	
	1030	

Information upon completion of well:


(1) Diameter 4" x 2 1/2" inches.
(2) Total Depth 1040' feet.
(3) Water Level 101 feet below top of ground.
(4) Cased to 992, Size 4" x 2 1/2"
(5) Screen: Size 2 1/2" 008, Length 30
(6) Were any formations sealed against pollution?
no yes, no.

If YES depth of formation _____

Why _____

Drillers Remarks:

Water has slight color

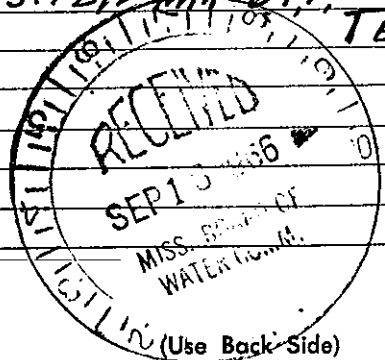

Well No.