

44ND5

MISSISSIPPI BOARD OF WATER COMMISSIONERS

Count 7/5/69
JWC

E23
3-9-65

WATER WELL DRILLERS LOG

CODED


Date: 2/9, 1965, Driller: Just Billing County: Scott
(Name)

(1) Owner of Land:	Description & Color of Materials Sand, Clay, Red Clay, Shell, etc.	Thick- ness Feet	Depth Feet
Bert Smith (Name)	Chalky Clay		40
Boy 372 - Jackson Drive (Address)	Gravel		41
30 6W3 W (Address)	Rock + Shell		102
(2) Location: 1/4, 1/4, Sec. T R	Blue Clay		123
3 miles East Edward (Distance) (direction) (Nearest Town)	Clay		137
(3) Topography:	Sand + slp. Shell		156
(Hilly) (Flat) (Level)	Fine sand + shell		165
(4) Purpose of Well: Home (Domestic Irrigation Municipal, Industrial, Other)	Shell		195
	Fine sand + shell		207
	Shell		218

Information upon completion of well:

- (1) Diameter 2 inches.
- (2) Total Depth 163 feet.
- (3) Water Level 45 feet below top of ground.
- (4) Cased to 158, Size 2"
- (5) Screen: Size 2", Length 5ft.
- (6) Were any formations sealed against pollution?
_____ yes, _____ no.

CODED

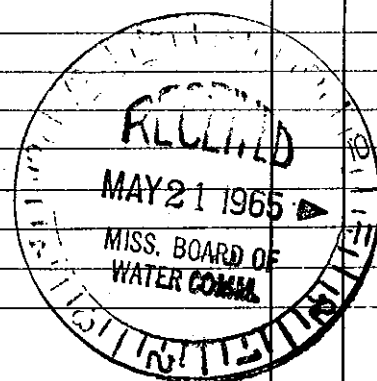

(Use Back Side)

Well No.

Mail this copy to Board of Water Commissioners 429 Miss. St. Jackson, Miss //