

HINDS  
E 2001  
6-4-62

MISSISSIPPI BOARD OF WATER COMMISSIONERS  
**WATER WELL DRILLERS LOG**

*Forest Drilling*

Date: 6/4, 1962, Driller: Johnnie Beasley County Hinds  
(Name)

	Description & Color of Materials Sand, Clay, Red Clay, Shell, etc.	Thick- ness Feet	Depth Feet
(1) Owner of Land: <u>Mrs. Sid Champion</u> (Name)	<u>Brown silt.</u>	<u>0-</u>	<u>18</u>
<u>Bolton, Miss.</u> (Address)	<u>Chalky clay.</u>	<u>18-</u>	<u>40</u>
(2) Location: <u>1/4</u> , <u>1/4</u> , Sec. <u>T6R3U</u>	<u>Clay &amp; lime.</u>	<u>40-</u>	<u>60</u>
<u>5 miles West</u> , of <u>Bolton</u> (distance) (direction) (Nearest Town)	<u>Lime rock &amp; clay.</u>	<u>60-</u>	<u>105</u>
On <u>Champion Hill road.</u>	<u>Hard blue clay.</u>	<u>105-</u>	<u>154</u>
(3) Topography: <u>X</u> (Hilly) (Flat) (Level)	<u>Fine sand. (Screen set.)</u>	<u>154-</u>	<u>162</u>
(4) Purpose of Well: <u>Domestic.</u> (Domestic Irrigation Municipal, Industrial, Other)	<u>Blue clay.</u>	<u>162-</u>	<u>300</u>


Information upon completion of well:

- (1) Diameter 2 inches.
- (2) Total Depth 162 feet.
- (3) Water Level 60 feet below top of ground.
- (4) Cased to 152', Size 2"
- (5) Screen: Size 2", Length 10'
- (6) Were any formations sealed against pollution?  
no.

If YES depth of formation \_\_\_\_\_  
Why \_\_\_\_\_

Drillers Remarks: The sand in this well  
real fine. Owner could not guarranty  
pay for well any deeper. May stop  
up with jet pump.

Retain this copy for your office files.

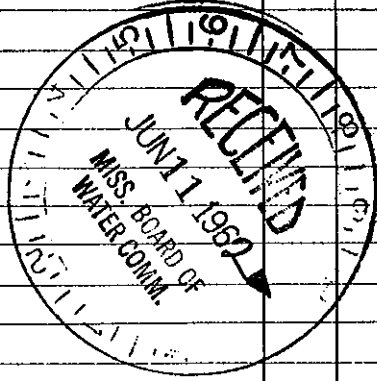

Well No.

(Use Back Side)