

HINDS

E 2004 MISSISSIPPI BOARD OF WATER COMMISSIONERS


1-26-65

WATER WELL DRILLERS LOG

Hinds

Date: 1/24, 1965, Driller: Forest Drilling Co. Scott

	Description & Color of Materials Sand, Clay, Red Clay, Shell, etc.	Thick- ness Feet	Depth Feet
(1) Owner of Land: <u>A. D. Martin</u> (Name)	Bypum Clay		38
<u>Rt 1 - Balton, Miss</u> (Address)	Rock		44
(2) Location: <u>1/4, 1/4, Sec. 34</u>	Blue clay		70
<u>North</u> of <u>Balton</u> (distance) (direction) (Nearest Town)	Rock		92
(3) Topography: _____ (Hilly) (Flat) (Level)	Rock + shls clay		102
(4) Purpose of Well: <u>Home</u> (Domestic Irrigation Municipal, Industrial, Other)	Rock		112
Information upon completion of well:	Clay + shls rock		122
(1) Diameter: <u>2</u> inches.	shaly shell + rock		132
(2) Total Depth: <u>338</u> feet.	Clay		162
(3) Water Level: <u>93</u> feet below top of ground.	Fine sand + shls clay		172
(4) Cased to: <u>328</u> , Size: <u>2"</u>	Clay + shls fine sand		182
(5) Screen: Size <u>2"</u> , Length <u>10 ft.</u>	Clay		202
(6) Were any formations sealed against pollution? _____ yes, <input checked="" type="checkbox"/> no.	Clay + shls fine sand		222
If YES depth of formation _____	Shell		242
Why _____	Shell + shls fine sand		282
Drillers Remarks: _____	Shell		307
_____	Fine sand + shell		327
_____	Fine sand		338

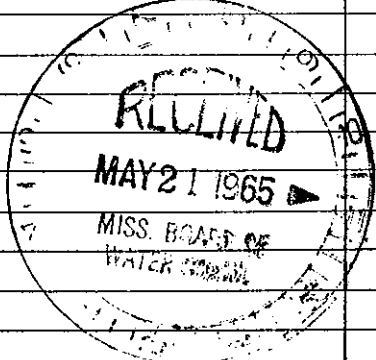

Well No.

(Use Back Side)

Mail this copy to Board of Water Commissioners 429 Miss. St. Jackson, Miss