

Hinds  
E 2006  
9-67

MISSISSIPPI  
BOARD OF WATER COMMISSIONERS  
416 North State Street  
Jackson, Mississippi 39201

WATER WELL DRILLERS LOG

9-15 1967 date well completed  
Trust Drilling firm name  
Hinds Madison county well located

LANDOWNER: Mr. W. E. Allen

Rt 2 Box 42  
Edwarda Miss  
(mailing address)

description of formations encountered

from to

Brown Clay	0	17
Sand + Gravel		23
Rock		27
Clay		40
Silt + Sh. Clay		87
Shale		102
Clay		122
Giny Sand		143
Clay		164


WELL LOCATION:

sec 30 T. 16 N R. 3 W E  
4 miles East of Edwarda  
(distance) (direction) (nearest town)

WELL PURPOSE: Home  
(home, irrigation, municipal, industrial)

WELL COMPLETION DATA:

- (1) diameter (inches) 2"
- (2) total depth (feet) 148
- (3) static water level (feet) 28 below above top of ground.
- (4) casing Galv, 143,  
(material) (depth)  
2"  
(size) If telescope see back.
- (5) screen 5 ft, 143  
(length) (depth to top)  
2"  
(size) Johnson  
(material)
- (6) pump 2, 1200 GPH  
(HP) (yield gpm)  
Elct  
(type power)
- (7) electric log No  
(yes or no)
- (organization running log)
- (8) how well bottom plugged Backwash  
value

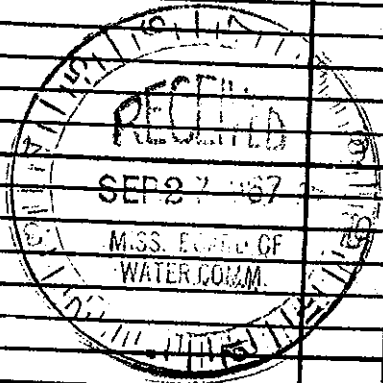

DRILLERS REMARKS: