

HINDS
F23


MISSISSIPPI BOARD OF WATER COMMISSIONERS

ELECT LOG MISS. GEOLOGICAL SURVEY
WATER WELL DRILLERS LOG

1-20-66

Date: 1-20, 1966, Driller: James McNeese County Hinds
E Log 241 (Name)

(1) Owner of Land: <u>Kathryn Williams</u> (Name)	Description & Color of Materials Sand, Clay, Red Clay, Shell, etc.	Thick- ness Feet	Depth Feet
<u>Clinton Miss</u> (Address)	Clay	20	20
(2) Location: <u>NE 1/4, SE 1/4, Sec 36 T6 N R2</u> <u>2 miles south</u> of <u>Clinton</u> (distance) (direction) (Nearest Town)	Blue shale	20	40
(3) Topography: <input checked="" type="checkbox"/> (Hilly) <input type="checkbox"/> (Flat) <input type="checkbox"/> (Level)	Sand lignite	20	60
(4) Purpose of Well: <u>Domestic</u> (Domestic Irrigation, Municipal, Industrial, Other)	Grey sdy sh	20	80
Information upon completion of well:	Grey shale	417	497
(1) Diameter: <u>4" x 2"</u> inches.	Rock	1	498
(2) Total Depth: <u>810</u> feet.	Grey sh	65	563
(3) Water Level: <u>186</u> feet below top of ground.	Sandy sh	20	583
(4) Cased to: <u>697</u> , Size: <u>4" x 2"</u>	Grey sh	23	606
(5) Screen: Size: <u>2" .007</u> , Length: <u>30</u>	Grey sdy sh	14	620
(6) Were any formations sealed against pollution? <input type="checkbox"/> yes, <input checked="" type="checkbox"/> no.	Sand	6	626
If YES depth of formation _____	Sandy sh	14	640
Why _____	Sand	6	646
Drillers Remarks: <u>White water</u>	Grey sh sd stks	9	655
	Sand	8	663
	Grey sdy sh sd stks	37	700
	Sand	25	725
	Grey sh sd stks	15	740
	Grey sh	30	770
	Grey sh sd stks	40	810
	16 Jts 4"	338	
	1 4x2 SWedge	1	
	17 Jts 2"	339	
	3-2" .007	30	
	1-Jt 2"	9	

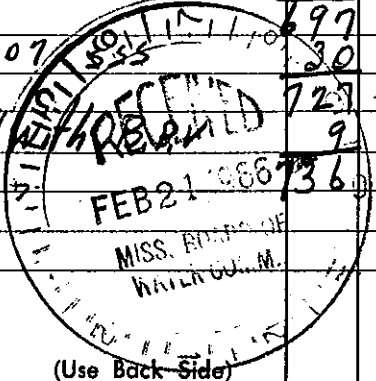

Well No.

Mail this copy to Board of Water Commissioners 429 Miss. St. Jackson, Miss