

Hinds
F-025
5-66

MISSISSIPPI BOARD OF WATER COMMISSIONERS


Electrical LOG. by - M. G. S.
WATER WELL DRILLERS LOG

226th 412

Date: 5-10, 1966, Driller: James McNEES County Hinds

(Name)

		Description & Color of Materials Sand, Clay, Red Clay, Shell, etc.	Thick- ness Feet	Depth Feet
(1) Owner of Land	<u>Virginia Bramlett</u> (Name)			
	<u>CLINTON MISS</u>	<u>SURFACE SOIL</u>	<u>5</u>	<u>5</u>
	(Address)	<u>Clay</u>	<u>38</u>	<u>43</u>
(2) Location:	<u>NE-SW-NW 36 6^N 2^W</u> 1/4, 1/4, Sec. T ₆ R ₂	<u>Grey shale</u>	<u>20</u>	<u>63</u>
	<u>2</u> miles <u>south^W</u> of <u>Clinton</u> (distance) (direction) (Nearest Town)	<u>Grey sh sand strcs</u>	<u>40</u>	<u>103</u>
(3) Topography:	<input checked="" type="checkbox"/> (Hilly) <input type="checkbox"/> (Flat) <input type="checkbox"/> (Level)	<u>Grey shale</u>	<u>462</u>	<u>565</u>
(4) Purpose of Well:	<u>Domestic</u> (Domestic Irrigation Municipal, Industrial, Other)	<u>Sand shale</u>	<u>34</u>	<u>599</u>
Information upon completion of well:		<u>Rock</u>	<u>1</u>	<u>600</u>
(1) Diameter	<u>4" x 2"</u> inches.	<u>Grey sh sand strcs</u>	<u>11</u>	<u>611</u>
(2) Total Depth	<u>789</u> feet.	<u>Grey shale</u>	<u>61</u>	<u>672</u>
(3) Water Level	<u>171</u> feet below top of ground.	<u>SAND</u>	<u>34</u>	<u>706</u>
(4) Cased to	<u>708</u> , Size <u>4" x 2"</u>	<u>Rock</u>	<u>1</u>	<u>707</u>
(5) Screen: Size	<u>2" 008</u> , Length <u>20</u>	<u>SAND</u>	<u>64</u>	<u>771</u>
(6) Were any formations sealed against pollution?	<input checked="" type="checkbox"/> yes, <input type="checkbox"/> no.	<u>Grey sdy sh</u>	<u>18</u>	<u>789</u>
If YES depth of formation		<u>16 fts 4"</u>	<u>338</u>	
Why		<u>1 4" x 2" SWedge</u>	<u>1</u>	
Drillers Remarks:	<u>Water White</u>	<u>17 fts 2"</u>	<u>339</u>	
		<u>1 - 2"</u>	<u>10</u>	<u>6</u>
		<u>2-10' 008 SSscreen</u>	<u>20</u>	<u>708</u>
		<u>1 ft 2" BRK</u>	<u>8</u>	<u>728</u>
			<u>736</u>	

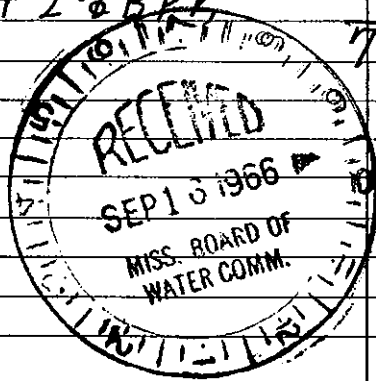

(Use Back Side)

Well No.

Mail this copy to Board of Water Commissioners 429 Miss. St. Jackson, Miss