


F34

HINDS MISSISSIPPI BOARD OF WATER COMMISSIONERS
F22 Elec LOG MISS GEOLOGICAL SURVEY
5-25-65 WATER WELL DRILLERS LOG

Date: 5-25, 1965, Driller: James McNeas County: Hinds

(Name)

| (1) Owner of Land | Description & Color of Materials Sand, Clay, Red Clay, Shell, etc. | Thick- ness Feet | Depth Feet |
|--|---|------------------------|---------------|
| N.S. Freshour (Name) Clinton Miss (Address) | SURFACE SOIL | 15 | 15 |
| | SAND ROCK | 5 | 20 |
| (2) Location: NW 1/4, SW 1/4, Sec. 18 To R2, N.W. | Blue shale - Fossils | 35 | 55 |
| 6 miles West of CLINTON (distance) (direction) (Nearest Town) | ROCK sh STKS | 40 | 95 |
| | Grey sdy sh | 59 | 154 |
| (3) Topography: <input checked="" type="checkbox"/> (Hilly) <input type="checkbox"/> (Flat) <input type="checkbox"/> (Level) | Grey sh | 8 | 162 |
| (4) Purpose of Well: DOMESTIC (Domestic Irrigation, Municipal, Industrial, Other) | Grey sh sd STKS | 29 | 191 |
| | Grey shale | 47 | 238 |
| | Grey sdy sh | 24 | 262 |
| | Grey shale | 40 | 302 |
| | Grey sdy shale | 36 | 338 |
| Information upon completion of well: | SAND | 37 | 375 |
| (1) Diameter: 4" x 2" inches. | Grey shale | 2 | 377 |
| (2) Total Depth: 857 feet. | SAND | 6 | 383 |
| (3) Water Level: 130 feet below top of ground. | SAND sh STKS | 21 | 404 |
| (4) Cased to: 814, Size: 4" x 2" | SAND | 17 | 421 |
| (5) Screen: Size: 2" 008, Length: 20 | SAND sh STKS | 10 | 431 |
| (6) Were any formations sealed against pollution? yes, <input checked="" type="checkbox"/> no. | 16 fts 4" | | 338 |
| If YES depth of formation | 1 4" x 2" swadge | | 1 |
| Why | 23 fts 2" | | 337 |
| Drillers Remarks: | 20' 2" 008 sss | | 475 |
| | 1-1/2" 2" Tail Pipe | | 814 |
| | 9 B.P.L. | | 20 |
| | | | 834 |
| | | | 6 |
| | | | 840 |

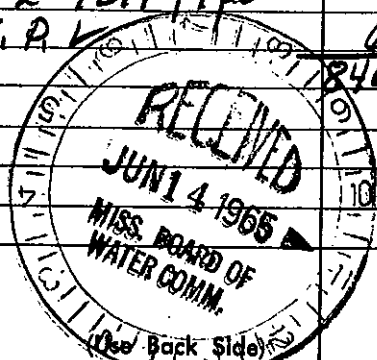

Well No.

Mail this copy to Board of Water Commissioners 429 Miss. St. Jackson, Miss.