

HINDS  
F 2001

MISSISSIPPI BOARD OF WATER COMMISSIONERS

6-14-62

WATER WELL DRILLERS LOG

Date: 6-14, 1962, Driller: James MENEES County HINDS

(Name)

(1) Owner of Land:	Description & Color of Materials Sand, Clay, Red Clay, Shell, etc.	Thick- ness Feet	Depth Feet
L. MAGEE (Name)	SURFACE SOIL	15	15
M <sup>o</sup> RAVEN ROAD (Address)	SAND	12	27
(2) Location SE 1/4, NW 1/4, Sec. 12, T <sup>3</sup> N, R <sup>2</sup> W	ROCK	4	31
2 1/2 miles NW of CLINTON (distance) (direction) (Nearest Town)	ROCK. sd STKS	9	40
(3) Topography: <input checked="" type="checkbox"/> (Hilly) <input type="checkbox"/> (Flat) <input type="checkbox"/> (Level)	Grey shale sd STKS	120	160
(4) Purpose of Well: Domestic Home (Domestic Irrigation, Municipal, Industrial, Other)	SAND and sh STKS	40	200
	SANDY sh	7	207
	SAND	10	217
	Grey shale	30	247

Information upon completion of well:

(1) Diameter 4x2 inches. *well dept 217'*

(2) Total Depth 247 feet.


(3) Water Level 47 feet below top of ground.

(4) Cased to 207', Size 4x2"

(5) Screen: Size 2.007, Length 10

(6) Were any formations sealed against pollution?  
 \_\_\_\_\_ yes,  no.

9 Jts 4"	189
1 4" coupling 4x2 stainless	1
1 Jt 2"	17
	207
1-2.007 stainless steel screen	10
	217
1-2" Beck wzh valve and nipple	1
	218

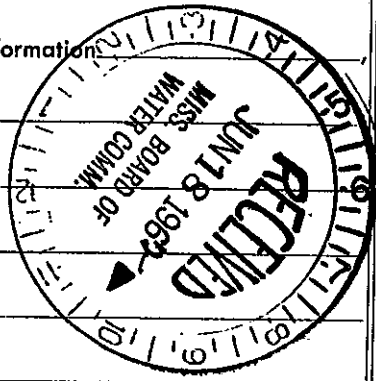

(Use Back Side)

Well No.

Mail this copy to Board of Water Commissioners 429 Miss. St. Jackson, Miss