


HINDS MISSISSIPPI BOARD OF WATER COMMISSIONERS

F 2003  
5-64

WATER WELL DRILLERS LOG  
(R.G.)

Date: MAY, 1964, Driller: MCNEECE DRILLING County HINDS  
(Name Co)

	Description & Color of Materials Sand, Clay, Red Clay, Shell, etc.	Thick- ness Feet	Depth Feet
(1) Owner of Land: <u>LAMAR BROOME</u> (Name)	SURFACE SOIL	12	12
<u>BOLTON MISS</u> (Address)	WHITE SHALE	12	24
(2) Location: <u>SW 1/4, NW 1/4, Sec. 36 T6N R24</u>	" "	18	42
' <u>2</u> miles <u>S</u> of <u>BOLTON</u> , (distance) (direction) (Nearest Town)	SHALE + SAND	24	66
(3) Topography: <u>FLAT</u> (Hilly) (Flat) (Level)	SAND	65	131
(4) Purpose of Well: <u>DOMESTIC</u> (Domestic Irrigation Municipal, Industrial, Other)	SHALE	9	140
Information upon completion of well:	ROCK LEDGES	46	186
(1) Diameter: <u>4 1/2</u> inches.	FINE SAND + SHALE	52	238
(2) Total Depth: <u>1145</u> feet.	MED. SAND	9	247
(3) Water Level: <u>1165</u> feet below top of ground. <u>1125</u>	SHALE, SAND + LIGNITE	30	277
(4) Cased to <u>347'</u> , Size <u>4"</u> <u>347' to 1145' - 2"</u>	SHALE	22	299
(5) Screen: Size <u>2"</u> , Length <u>20'</u>	" "	50	807
(6) Were any formations sealed against pollution? <u>yes</u> , <u>X</u> no.	SHELL SHALE + SAND	30	837
If YES, depth of formation _____	SHALE + LIGNITE	27	864
Why _____	FINE SAND	10	874
Drillers Remarks: _____	SHALE	20	894
_____	FINE SAND	12	906
_____	SHALE + SAND	46	952
_____	FINE SAND	10	962
_____	SHALE + SAND	36	998
_____	" "	103	1111
_____	SAND	25	1136
_____	SHALE	9	1145
_____			
_____			
_____			

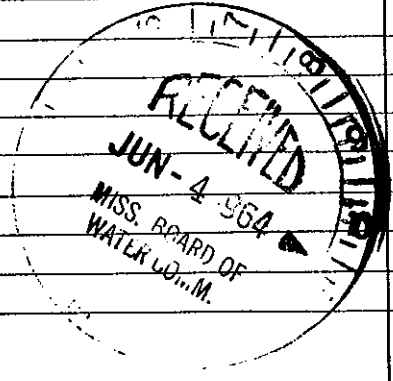

Well No. 292

(Use Back Side)

Mail this copy to Board of Water Commissioners 429 Miss. St. Jackson, Miss.