


**HINDS** MISSISSIPPI BOARD OF WATER COMMISSIONERS  
**F 2004**  
**5-10-66** **WATER WELL DRILLERS LOG**

Date: 5-10-66, Driller: JAMES MCNEES County HINDS  
 (Name)

	Description & Color of Materials Sand, Clay, Red Clay, Shell, etc.	Thick- ness Feet	Depth Feet
(1) Owner of Land: <u>Virginia Bramlette</u> (Name) <u>CLINTON MISS</u> (Address)	SURFACE SOIL	5	5
(2) Location: <u>3/4</u> , <u>1/4</u> , Sec. <u>36</u> <u>T1N</u> <u>R2W</u>	CLAY	38	43
<u>2</u> miles <u>south</u> of <u>CLINTON</u> (distance) (direction) (Nearest Town)	Grey shale	20	63
(3) Topography: <input checked="" type="checkbox"/> (Hilly) <input type="checkbox"/> (Flat) <input type="checkbox"/> (Level)	Grey sh sd STKS	40	103
(4) Purpose of Well: <u>Domestic Home</u> (Domestic Irrigation Municipal, Industrial, Other)	Grey shale	462	565
Information upon completion of well:	SEND SH STKS	31	599
(1) Diameter: <u>4" x 2"</u> inches.	ROCK	1	600
(2) Total Depth: <u>792</u> feet.	Grey sh sd STKS	11	611
(3) Water Level: <u>184'</u> feet below top of ground.	Grey shale	61	672
(4) Cased to: <u>708'</u> , Size: <u>4" x 2"</u>	SEND	54	706
(5) Screen: Size: <u>2"</u> , Length: <u>20</u>	ROCK	1	707
(6) Were any formations sealed against pollution? <input type="checkbox"/> yes, <input checked="" type="checkbox"/> no.	SEND	44	751
If YES depth of formation _____	SEND SH STKS	20	771
Why _____	Grey sdy sh	21	792
Drillers Remarks: _____	16 fts 4"	338	
	1- 4" x 2" swedge	1	
	17 fts 2"	339	
	1 - 2"	10	6
	2- 10' 008. SSS	708	12
	1-ft 2" BPV	20	
		728	
		8	
		736	

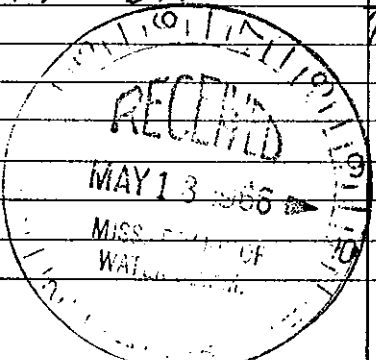

(Use Back Side)

Well No.

Mail this copy to Board of Water Commissioners 429 Miss. St. Jackson, Miss