

F2017

Hinds
FL3
9-14-81

MISSISSIPPI
BOARD OF WATER COMMISSIONERS
416 North State Street
Jackson, Mississippi 39201

CODED

WATER WELL DRILLERS LOG

9/14/81
date well completed

Jack Signer water
well name

Hinds
county well located

LANDOWNER: Denny White
well no. 2.

description of formations encountered	from	to
Red sand	0	80
Clay	80	420
Sand	420	440
Sand	440	580

(mailing address)

WELL LOCATION:
sec 25 (T) 6 (N) R 2 (E)
10 miles of Jackson
(distance) (direction) (nearest town)

WELL PURPOSE: Home
(home, irrigation, municipal, industrial)

WELL COMPLETION DATA:

- (1) diameter (inches) 4 in
- (2) total depth (feet) 284
- (3) static water level (feet) 164 below top of ground.
- (4) casing P.V.C. 530 ft
(material) (depth)
4 in (size) If telescope see back.
- (5) screen 40 ft 20 ft
(length) (depth to top)
4 in P.V.C.
(size) (material)
- (6) pump 5 H.P. 42 gal.
(HP) (yield gpm)
Electric
(type power)
- (7) electric log yes
(yes or no)
M. S. S.
(organization running log)
- (8) how well bottom plugged Back Wash
value

CODED

DRILLERS REMARKS:


DEPT. OF NATURAL RESOURCES
BUREAU OF LAND & WATER RESOURCES

NOV 9 - 1981

RECEIVED

If well telescopes please sketch and show depths.

GROUND LEVEL

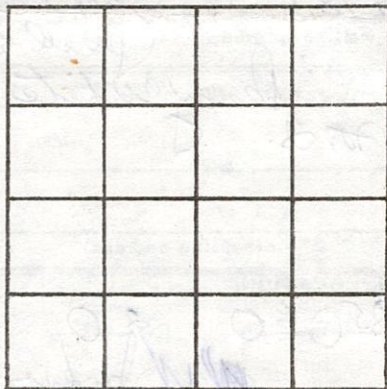

SECTION _____

Please indicate well location X.

ADDITIONAL INFORMATION

If more than one screen,
show locations of each on sketch.