

MISSISSIPPI BOARD OF WATER COMMISSIONERS

HINDS  
G


WATER WELL DRILLERS LOG

300

7-5-60

Date: 7/5, 19 60, Driller: Layne-Central Co. County Hinds  
(Name)

(1) Owner of Land: <u>C. A. Caldwell</u> (Name)	Description & Color of Materials Sand, Clay, Red Clay, Shell, etc.	Thick- ness Feet	Depth Feet
<u>Jackson, Miss.</u> (Address)	Brown clay	35	35
(2) Location: <u>1/4</u> , <u>1/4</u> , Sec. <u>    </u> T. <u>    </u> R. <u>    </u>	Blue clay	185	220
<u>1/2</u> miles <u>West</u> of <u>Jackson</u> (distance) (direction) (Nearest Town)	Clay & shale	90	310
<u>Wiggins Road</u> (Address)	Clay	161	471
(3) Topography: <u>X</u> (Hilly) (Flat) (Level)	Fine sand & shale	44	515
(4) Purpose of Well: <u>Domestic</u> (Domestic, Irrigation, Municipal, Industrial, Other)	Hard shale	47	562
Information upon completion of well:	Rock	1	563
(1) Diameter <u>4"</u> inches.	Hard shale	7	570
(2) Total Depth <u>917</u> feet.	Hard rock	3	573
(3) Water Level <u>271</u> feet below top of ground.	Hard shale	77	650
(4) Cased to <u>879</u> , Size <u>4"</u>	Rock	4	654
(5) Screen: Size <u>4"</u> , Length <u>30'</u>	Hard shale	22	676
(6) Were any formations sealed against pollution? <u>    </u> yes, <u>X</u> no.	Shale & fine sand	194	870
If YES depth of formation <u>    </u>	Sand	47	917
Why <u>    </u>			
Drillers Remarks: <u>    </u>			

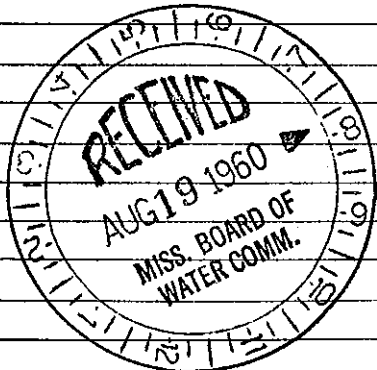

(Use Back Side)

Well No.

Mail this copy to Board of Water Commissioners 429 Miss. St. Jackson, Miss