

HINDS MISSISSIPPI BOARD OF WATER COMMISSIONERS

G

11-2-60

WATER WELL DRILLERS LOG

G 301

Date: NOV. 2, 1960, Driller: McNEECE DRILLING CO. County HINDS

(Name)

(1) Owner of Land: H.C. BAILEY
(Name)
JACKSON, MISS.
(Address)
E. 1/2 OF LOT 2 GARLAND FARMS SUB.
 (2) Location: 1/4, 1/4, Sec. T R,
BLACKMON RD.
2 miles NW, of JACKSON
(distance) (direction) (Nearest Town)
 (3) Topography: FLAT
(Hilly) (Flat) (Level)
 (4) Purpose of Well: DOMESTIC
(Domestic Irrigation Municipal, Industrial, Other)

Description & Color of Materials Sand, Clay, Red Clay, Shell, etc.	Thick- ness Feet	Depth Feet
CLAY SOIL	12	0
YELLOW MUD	28	12
GREY SHALE	220	40
ROCK	4	260
SHELL & SAND	22	264
FINE SAND	12	286
GREY SHALE	44	288
SHALE, LG. & FINE SAND	134	342
SHALE	34	476
SAND & SHALE	47	510
SHALE	133	557
COARSE SAND	63	690
		753


Information upon completion of well:

- (1) Diameter 4"x2" inches.
- (2) Total Depth 753 feet.
- (3) Water Level 254 feet below top of ground.
- (4) Cased to 330, Size 4"
330'-753' - 2"
- (5) Screen: Size 2", Length 20'
- (6) Were any formations sealed against pollution?
 yes, no.

If YES depth of formation _____

Why _____

Drillers Remarks: _____

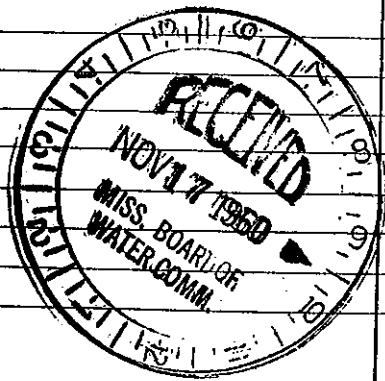

(Use Back Side)

Well No. 7

Mail this copy to Board of Water Commissioners 429 Miss. St. Jackson, Miss