

HINDS

MISSISSIPPI BOARD OF WATER COMMISSIONERS

G  
10-16-61

WATER WELL DRILLERS LOG

Forest drilling H-304

Date: 10/16, 1961, Driller: Johnnie Beasley County Hinds  
(Name)

	Description & Color of Materials Sand, Clay, Red Clay, Shell, etc.	Thick- ness Feet	Depth Feet
(1) Owner of Land: <u>Frank Marchant</u> Take Hwy. 49 North out of Jackson Jackson Miss.	Brown clay.		0-30
go just beyond race track and turn	Blue clay.		30-265
(2) Location: <u>1/4</u> , <u>1/4</u> , Sec. <u>T k</u> , right and go to forks of road and he lives in fork.	Shale & lime.		265-328
_____ of _____	Shale & stks. silt.		328-368
(3) Topography: <u>x</u> (Hilly) (Flat) (Level)	Shale.		368-400
(4) Purpose of Well: <u>Domestic.</u> (Domestic Irrigation Municipal, Industrial, Other)	Fine sand.		400-412
	Shale.		412-440
	Shale & silt.		440-480
	Sand. (Screen setting)		480-500


Information upon completion of well:

- (1) Diameter 2 inches.
- (2) Total Depth 500' feet.
- (3) Water Level 156' feet below top of ground.
- (4) Cased to 480', Size 2"
- (5) Screen: Size 2", Length 20'
- (6) Were any formations sealed against pollution?  
no

If YES depth of formation \_\_\_\_\_

Why \_\_\_\_\_

Drillers Remarks: Fair well.

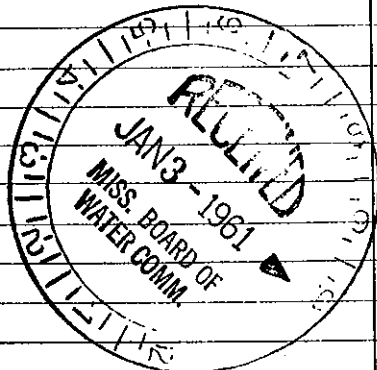

(Use Back Side)

Well No.

Retain this copy for your office files.