

G  
10-61

WATER WELL DRILLERS LOG


G-301

Date: OCT., 1961, Driller: MCNEECE DRILLING County HINDS  
(Name CO)

(1) Owner of Land: <u>MR C. M. KELLEY</u> (Name)	Description & Color of Materials Sand, Clay, Red Clay, Shell, etc.	Thick- ness Feet	Depth Feet
<u>917 N. MONROE, CLINTON MISS</u> (Address)	SURFACE SOIL	3	0
(2) Location: <u>NE 1/4, S 1/2 NW 1/4, Sec. 18 T6 N1W</u>	RED SAND	37	<del>12</del>
<u>2</u> miles <u>N</u> , of <u>CLINTON</u> , (distance) (direction) (Nearest Town)	LIGNITE	5	40
(3) Topography: <u>HILLY</u> (Hilly) (Flat) (Level)	FINE SAND + SHALE	22	45
(4) Purpose of Well: <u>DOMESTIC</u> (Domestic Irrigation Municipal, Industrial, Other)	GREY SHALE	478	67
	SHALE SHELL + SAND	20	545
	SHALE	14	565
	SHALE + SAND	59	579
	COARSE SAND	62	638
			700

Information upon completion of well:

- (1) Diameter 4 1/2 inches.
- (2) Total Depth 700 feet.
- (3) Water Level 204 feet below top of ground.
- (4) Cased to 355', Size 4"  
355' - 700' / 2"
- (5) Screen: Size 2", Length 40.
- (6) Were any formations sealed against pollution?  
\_\_\_\_\_ yes, X no.
- If YES depth of formation \_\_\_\_\_
- Why \_\_\_\_\_
- Drillers Remarks: \_\_\_\_\_

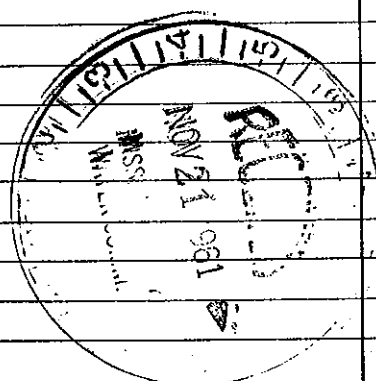

(Use Back Side)

Well No.  
34