


Hinds
 6-11-67
 3-67
 Elec 209
 3/20/67

MISSISSIPPI
 BOARD OF WATER COMMISSIONERS
 416 North State Street
 Jackson, Mississippi 39201

WATER WELL DRILLERS LOG OF
 MISSISSIPPI WATER COMM.

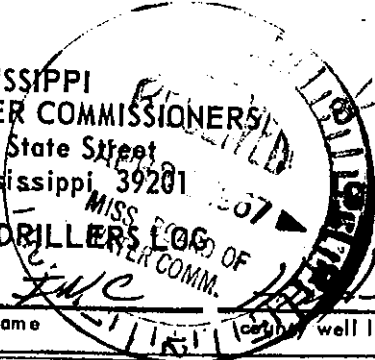

Water Wells Inc
 date well completed firm name location well located


LANDOWNER: B.T. Duckworth
 RT. 1, BOX 21-D
 Clinton, Miss
 (mailing address)

description of formations encountered	from	to
Reddish weathered clay	0	12
Red sandy clay	12	22
Blue clay & shale	22	470
Grey soft sandy shale	470	625
Crack-bleed sandy shale with limonite streaks	625	750
white medium sand	750	820
Dark shale	820	833

WELL LOCATION:
 sec. C T 6 N R 1 & W
 2 miles SE of TWINN
 (distance) (direction) (nearest town)

WELL PURPOSE: HOME
 (home, irrigation, municipal, industrial)

WELL COMPLETION DATA:
 (1) diameter (inches) 4
 (2) total depth (feet) 833
 (3) static water level (feet) 155 below top of ground.
 (4) casing STEEL, 232 (material) (depth)
 4 (size) If telescope see back.
 (5) screen 18' 812 (length) 778 (depth to top) (size) Stainless Steel (material)
 (6) pump 2 27 (HP) (yield gpm)
 220 volts (type power)
 (7) electric log yes (yes or no)
 MISS. G. S. (organization running log)
 (8) how well bottom plugged 14" Lock-Nose Valve

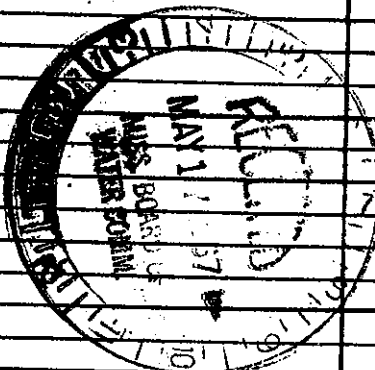

DRILLERS REMARKS: set split screens - 778-790 & 812-818' (4" casing wedge down to 2")