

HINDS MISSISSIPPI BOARD OF WATER COMMISSIONERS

G ~~50~~ 6700 8/5/17  
9-5-63

WATER WELL DRILLERS LOG

CODED  
CODED ✓

Date: 9-5-1963, Driller: Layne-Central Co. County Hinds  
(Name)

(1) Owner of Land: <u>Town of Clinton</u> (Name)	Description & Color of Materials Sand, Clay, Red Clay, Shell, etc.	Thick- ness Feet	Depth Feet
<u>Clinton, Mississippi</u> (Address)	yellow clay	35	0
	Yazoo clay	265	300
	shale	90	390
(2) Location: <u>1/4, 1/4, Sec. T R</u>	shale stks sand	218	608
<u>      </u> miles <u>      </u> of <u>      </u> (distance) (direction) (Nearest Town)	hard shale	93	701
	rock	2	703
(3) Topography: <u>      </u> (Hilly) (Flat) (Level)	shale stks rock	19	722
	shale stks sand	8	830
(4) Purpose of Well: <u>Municipal</u> (Domestic Irrigation Municipal, Industrial, Other)	sand	96	926
	shale	4	930


Information upon completion of well:

- (1) Diameter 12 inches.
- (2) Total Depth 924 feet.
- (3) Water Level 191 feet below top of ground.
- (4) Cased to 832', Size 12"
- (5) Screen: Size 8", Length 80'
- (6) Were any formations sealed against pollution?  
X yes,        no.

If YES depth of formation 832'

Why        required

Drillers Remarks:       

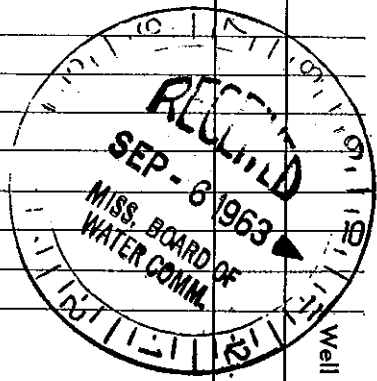

(Use Back Side)

Mail this copy to Board of Water Commissioners 429 Miss. St. Jackson, Miss.