

Hinds MISSISSIPPI BOARD OF WATER COMMISSIONERS

G 73  
10-65

WATER WELL DRILLERS LOG

CODED


Date: OCT 8, 1965, Driller: HALL DRILLING CO County HINDS  
(Name)

(1) Owner of Land: <u>DIXIE WATER CO</u> (Name)	Description & Color of Materials Sand, Clay, Red Clay, Shell, etc.	Thick- ness Feet	Depth Feet
<u>P.O. BOX 8127 JACKSON MISS</u> (Address)	<u>SURFACE SOIL</u>	<u>3</u>	<u>3</u>
(2) Location: <u>SE 1/4</u> , <u>1/4</u> , Sec. <u>19</u> <u>T6R1W</u>	<u>YELLOW MARL</u>	<u>25</u>	<u>28</u>
<u>1/4</u> miles <u>N.W.</u> , of <u>JACKSON</u> (distance) (direction) (Nearest Town)	<u>SHALE SAND + GRAVEL</u>	<u>40</u>	<u>68</u>
(3) Topography: <u>FLAT</u> (Hilly) (Flat) (Level)	<u>YAZOO CLAY</u>	<u>59</u>	<u>127</u>
(4) Purpose of Well: <u>MUNICIPAL</u> (Domestic Irrigation Municipal, Industrial, Other)	<u>MOODY BRANCH</u>	<u>12</u>	<u>139</u>
	<u>SAND + SHALE</u>	<u>21</u>	<u>160</u>
	<u>SAND SHALE + LIGNITE</u>	<u>95</u>	<u>255</u>
	<u>SHALE ROCK + SAND</u>	<u>118</u>	<u>373</u>
	<u>BROWN SHALE C.M.</u>	<u>77</u>	<u>450</u>
	<u>ROCK + SHALE</u>	<u>84</u>	<u>534</u>
	<u>COURSE SAND</u>	<u>64</u>	<u>598</u>

Information upon completion of well:

- (1) Diameter 6 X 4 inches.
- (2) Total Depth 598 feet.
- (3) Water Level 189 feet below top of ground.
- (4) Cased to 400' / 248', Size 6 / 4
- (5) Screen: Size 4, Length 50'
- (6) Were any formations sealed against pollution?  
no yes, X no.

If YES depth of formation \_\_\_\_\_  
Why \_\_\_\_\_  
Drillers Remarks: \_\_\_\_\_

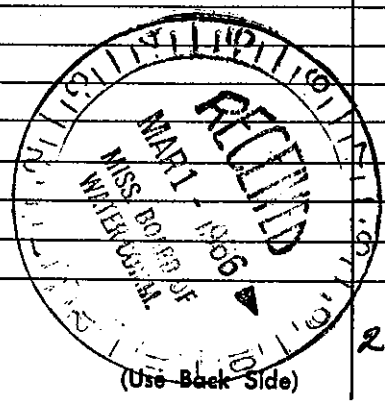

Well No. 21

Mail this copy to Board of Water Commissioners 429 Miss. St. Jackson, Miss.