

Hinds
 6-676
 3-67
 Elec 209
 3/20/67

MISSISSIPPI
 BOARD OF WATER COMMISSIONERS
 416 North State Street
 Jackson, Mississippi 39201

LOG NO.
 #266

WATER WELL DRILLERS LOG

3/20/67 date well completed
 Water Wells firm name
 Hinds county well located

LANDOWNER: B.T. Duckworth
 RT. 1, BOX 21-D
 Clinton, Miss
 (mailing address)

WELL LOCATION:
 sec. C T 6 N R 1 W
 2 miles SE of TWINN
 (distance) (direction) (nearest town)

WELL PURPOSE: HOME
 (home, irrigation, municipal, industrial)

WELL COMPLETION DATA:
 (1) diameter (inches) 4
 (2) total depth (feet) 833
 (3) static water level (feet) 153 below top of ground.
 (4) casing STEEL, 232 (material) (depth)
 4 (size) if telescope see back.
 (5) screen 18' 812 (6') (length) (depth to top)
 1 1/2" Stainless Steel (size) (material)
 (6) pump 2 27 (HP) (yield gpm)
 220 Volts (type power)
 (7) electric log yes (yes or no)
 Miss. G. S. (organization running log)
 (8) how well bottom plugged 1 1/4" Back-wash valve

description of formations encountered	from	to
Reddish weathered clay	0	12
Red sandy clay	12	22
Blue Clay & shale	22	470
Grey spl & sandy shale	470	625
Grey black sandy shale with lignite streaks	625	750
white Medium sand	750	820
Dark shale	820	833
		T.D.

DRILLERS REMARKS: set split screens - 778'-790' & 812'-818' (4" casing wedge down to 2")



If well telescopes please sketch and show depths.

GROUND LEVEL

4x2 sledge

232'
Bottom of 4"
Top of 2"

778'
Bottom of 2"
Top of screen


Bottom of screen
790'

21' spacer pipe

812'
Top of screen

818'
Bottom of screen

833 TD

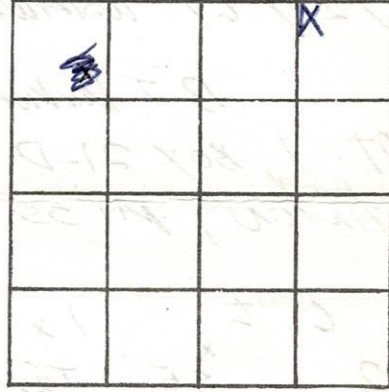

SECTION 6

Please indicate well location X.

ADDITIONAL INFORMATION

If more than one screen, show locations of each on sketch.