

MISSISSIPPI
BOARD OF WATER COMMISSIONERS
416 North State Street
Jackson, Mississippi 39201

WATER WELL DRILLERS LOG

Hinds
G-77
7-67
Elec Log
7/81
date well completed

19 Waterwells, Inc. firm name
Hinds county well located

LANDOWNER: S. A. MUNNIAH

Route 2

JACKSON, MISS
(mailing address)

WELL LOCATION:
sec 15 T. 6 N R. 1 W
2 miles West of Jackson
(distance) (direction) (nearest town)


WELL PURPOSE: Domestic
(home, irrigation, municipal, industrial)

WELL COMPLETION DATA:

- (1) diameter (inches) 4 x 2"
(2) total depth (feet) 452'
(3) static water level (feet) 168 below
top of ground.
(4) casing 4", 253'
(material) (depth)
(size) if telescope see back.
(5) screen 10', 398'
(length) (depth to top)
1/4", stainless steel
(size) (material)
(6) pump 3/4 10 gpm
(HP) (yield gpm)
220 volts submersible
(type power)
(7) electric log yes
(yes or no)
MISS USGS
(organization running log)
(8) how well bottom plugged 1/4"
back-wash valve

description of formations encountered	from	to
<u>weathered clay</u>	<u>0</u>	<u>5</u>
<u>Blue clay - 42206</u>	<u>5</u>	<u>105</u>
<u>fine sand & shale</u>	<u>105</u>	<u>190</u>
<u>Grey shale - sand streaks</u>	<u>190</u>	<u>325</u>
<u>fine sand</u>	<u>325</u>	<u>340</u>
<u>sandy shale</u>	<u>340</u>	<u>390</u>
<u>medium grey sand</u>	<u>390</u>	<u>420</u>
<u>shaly sand</u>	<u>420</u>	<u>442</u>
<u>blue clay</u>	<u>442</u>	<u>454</u>

TD 454'

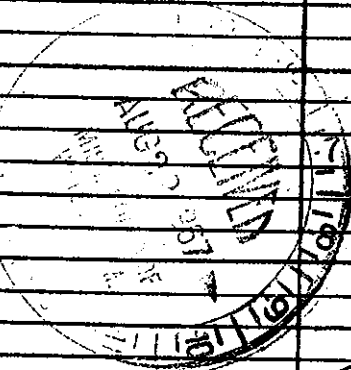

DRILLERS REMARKS:

Elevation 305'
samples at survey
dump sitting 210'