

ELOG # 285

HINDS

G 78

- 68

MISSISSIPPI BOARD OF WATER COMMISSIONERS
416 North State Street
Jackson, Mississippi 39201

CODED ✓

WATER WELL DRILLERS LOG

date well completed

firm name

county well located

Forest Drilling & Sew Hinds

LANDOWNER: R.W. Gardner

description of formations encountered

from to

Box 11189

Brown Clay 0 36

Jackson, Miss.
(mailing address)

Blue Clay 36 301

WELL LOCATION:

sec. 17 T. 6 N R. 1 E

Shale 301 342

1 1/2 miles N/E of Clinton
(distance) (direction) (nearest town)

Clay & Shale Sand shell 342 367

WELL PURPOSE: Home
(home, irrigation, municipal, industrial)

Shale + Shale 7' Sand 367 403

WELL COMPLETION DATA:

(1) diameter (inches) 2"

Shale 403 423

(2) total depth (feet) 615 ft

Soft Shale 423 464

(3) static water level (feet) 170 below top of ground.

Shale + Shale + Sand 464 505

(4) casing Galv. 600
(material) (depth)

Shale 505 547

2" If telescope see back.
(size)

Soft Shale 547 564

(5) screen 15 ft, 600
(length) (depth to top)

Soft Shale + Sand 564 577

2" Stainless Steel
(size) (material)

Soft Shale 577 597

(6) pump 5 20
(HP) (yield gpm)

Soft Shale 597 618


220V
(type power)

Thin Sand 618

(7) electric log No
(yes or no)

(organization running log)

(8) how well bottom plugged Backwash valve

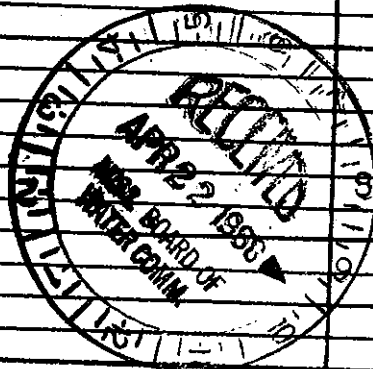

DRILLERS REMARKS: