

Hinds  
G-30  
7-66

MISSISSIPPI BOARD OF WATER COMMISSIONERS

WATER WELL DRILLERS LOG

Date: 14 July, 19 66, Driller: WATERWELLS, INC. County: HINDS

(Name)

(1) Owner of Land: M. F. Hickson  
(Name)  
765 Broadmore Drive, Jackson  
(Address)

(2) Location: SE 1/4, NW 1/4, Sec. 15 T. 6 R. 14  
3 miles NW, of Jackson  
(distance) (direction) (Nearest Town)

(3) Topography: Hilly  
(Hilly) (Flat) (Level)

(4) Purpose of Well: Commercial  
(Domestic Irrigation  
Municipal, Industrial, Other)

Description & Color of Materials Sand, Clay, Red Clay, Shell, etc.	Thick- ness Feet	Depth Feet
Weathered section clay	0	10
Bluish clay	10	22
Gravel-small to very Lg.	22	23?
Blue clay	23	112
Blue-grey shale	112	138
Grey, fine sandy shale	138	250
Blue-black soft shale	250	274
Shale-sand streaks	274	355
Grey -med. gr sand	355	423TD

Information upon completion of well:

(1) Diameter 4 inches.

(2) Total Depth 423 feet.

(3) Water Level 124 feet below top of ground.

(4) Cased to 294, Size 4"


(5) Screen: Size 4" 2", Length 40'

(6) Were any formations sealed against pollution?  
X yes,        no.

If YES depth of formation top 10'

Why \_\_\_\_\_

Drillers Remarks: Cockfield well  
test excess 80gpm, Pumping 47gpm  
Samples & Electric at Miss. G.S.

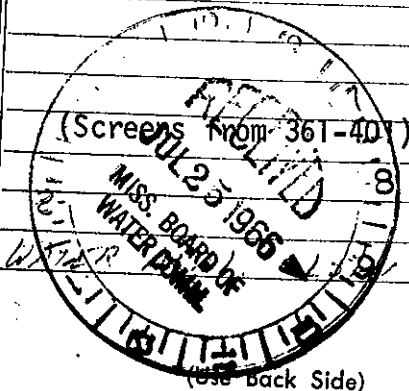

(Use back Side)

Well No.

Retain this copy for your office files.