

HINDS

MISSISSIPPI BOARD OF WATER COMMISSIONERS

H

WATER WELL DRILLERS LOG


H-302

5-30-61

Date: May 30, 1961, Driller: Layne-Central Co. County: Hinds

(Name)

(1) Owner of Land: <u>Dixie Water Co.</u> (Name)	Description & Color of Materials Sand, Clay, Red Clay, Shell, etc.	Thick- ness Feet	Depth Feet
<u>Jackson, Mississippi</u> (Address)	yellow clay	0	45
(2) Location: <u>1/4, 1/4, Sec. T R</u>	blue clay 45-89		44
<u>_____</u> miles, of <u>_____</u> (distance) (direction) (Nearest Town)	shale 89-210		121
(3) Topography: _____ (Hilly) (Flat) (Level)	hard shale 210-289		79
(4) Purpose of Well: <u>Domestic-Subdivis</u> (Domestic Irrigation, Municipal, Industrial, Other)	shale 289-450		161
Information upon completion of well:	shale st. sand 450-470		20
(1) Diameter: <u>8"</u> inches.	sand few st. shale 470-572		102
(2) Total Depth: <u>551'</u> feet.	shale st. rock 572-147		147
(3) Water Level: <u>110</u> feet below top of ground.	on fine sand-shale 719-899		180
(4) Cased to: <u>466'</u> , Size: <u>8"</u>			
(5) Screen: Size: <u>4"</u> , Length: <u>70'</u>			
(6) Were any formations sealed against pollution? <u>X</u> yes, _____ no.			
If YES depth of formation: <u>466'</u>			
Why: <u>Required</u>			
Drillers Remarks: _____			

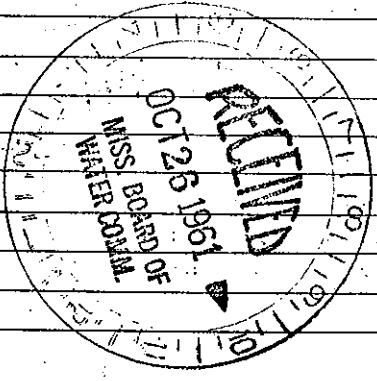

(Use Back Side)

Well No.

Mail this copy to Board of Water Commissioners 429 Miss. St. Jackson, Miss.