

HINDS MISSISSIPPI BOARD OF WATER COMMISSIONERS

H 0002

WATER WELL DRILLERS LOG

~~1190~~

8-10-65

Date: AUG 10, 1965, Driller: HALL DRILLING County HINDS
(Name)

	Description & Color of Materials Sand, Clay, Red Clay, Shell, etc.	Thick- ness Feet	Depth Feet
(1) Owner of Land: <u>HINDS COUNTY WATER CO</u> (Name)	SURFACE SOIL	7	7
<u>P.O. 8124 JACKSON MISS</u> (Address)	YELLOW MARL	15	22
(2) Location: <u>SE 1/4, SW 1/4, Sec. 6 T6 R2E</u>	BLUE SHALE	212	234
<u>1.4</u> miles <u>N</u> , of <u>JACKSON</u> (distance) (direction) (Nearest Town)	MOODY BRANCH	15	249
(3) Topography: <u>FLAT</u> (Hilly) (Flat) (Level)	SAND + SHALE +		
(4) Purpose of Well: <u>MUNICIPAL</u> (Domestic Irrigation Municipal, Industrial, Other)	LIGNITE	201	450
	SAND HARD SHALE	70	520
	SHALE + ROCK	140	660
	SAND SHALE + LIG	162	822


Information upon completion of well:

- (1) Diameter 6x4 inches.
- (2) Total Depth 822 feet.
- (3) Water Level 186 feet below top of ground.
- (4) Cased to 400', Size 6"
80' 4"
- (5) Screen: Size 4", Length 40'
- (6) Were any formations sealed against pollution?
no.

If YES depth of formation _____

Why _____

Drillers Remarks: _____

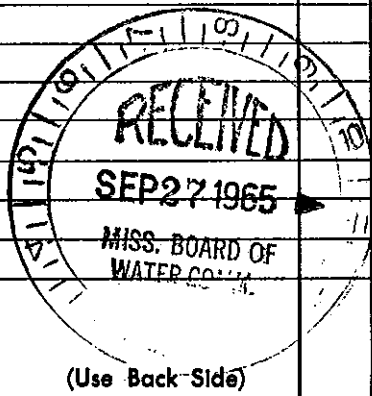

Well No. 18

(Use Back Side)

Mail this copy to Board of Water Commissioners 429 Miss. St. Jackson, Miss