

GW02244


HINDS
H-133
12-4-62

MISSISSIPPI BOARD OF WATER COMMISSIONERS

WATER WELL DRILLERS LOG

Date: Dec. 4, 19 62, Driller: Layne-Central, Co. County Hinds
(Name)

(1) Owner of Land: Jackson Country Club (Name)	Description & Color of Materials Sand, Clay, Red Clay, Shell, etc.	Thick- ness Feet	Depth Feet
Jackson, Mississippi (Address)	soil	0	1
	yellow clay	20	20
	blue clay	259	289
(2) Location: 1/4, 1/4, Sec. 4 GN 2E T. R.	sandy shaley shells	8	288
_____ miles _____ of _____ (distance) (direction) (Nearest Town)	rock	2	290
(3) Topography: _____ (Hilly) (Flat) (Level)	sandy shale	12	302
(4) Purpose of Well: Country Club (Domestic Irrigation, Municipal, Industrial, Other)	sand shale & hard pan	17	319
Information upon completion of well:	rock	1	320
(1) Diameter 12" inches.	sand shale & lignite	30	350
(2) Total Depth 581' feet.	clay stks. sandy	115	465
(3) Water level 82' feet below top of ground.	fine sand & clay stks	40	505
(4) Cased to 510' , Size _____	h. p. sand (some bks.		
(5) Screen: Size 8" , Length 60'	shale(well made here)	77	582
(6) Were any formations sealed against pollution?	clay	4	586
Yes yes, _____ no.			
If YES depth of formation 510'			
Why Required			
Drillers Remarks:			

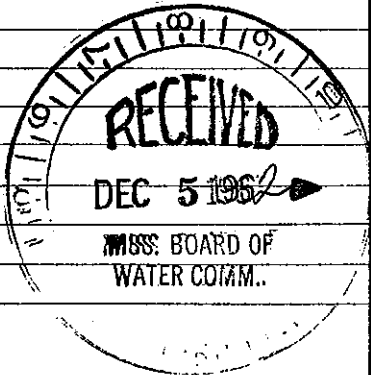

(Use Back Side)

Well No.

Mail this copy to Board of Water Commissioners 429 Miss. St. Jackson, Miss