

HINDS

MISSISSIPPI BOARD OF WATER COMMISSIONERS

H-134

5-23-62

WATER WELL DRILLERS LOG

Date: 5-23, 1962, Driller: James McNeas County Hinds


(Name)

(1) Owner of Land	Description & Color of Materials Sand, Clay, Red Clay, Shell, etc.	Thick- ness Feet	Depth Feet
Homewood McNeas (Name)	SURFACE SOIL	10	10
JACKSON (Address)	Blue shale	80	90
(2) Location: SE 1/4, NW 1/4, Sec. 11 T16N R1E City (distance) (direction) (Nearest Town)	SAND	10	100
(3) Topography: <input checked="" type="checkbox"/> (Hilly) <input type="checkbox"/> (Flat) <input type="checkbox"/> (Level)	Grey shale - sand		
(4) Purpose of Well: <u>Trailer court</u> (Domestic Irrigation Municipal, Industrial, Other)	2nd Lignite strk	70	170
	SAND	30	200
	Grey shale sand strk	180	380
	Grey sdy sh	42	422
	Brown shale	61	483
	ROCK	1	484
	Brown shale	20	504
	ROCK	1	505
	Brown shale	40	545
	SAND	10	555
	Brown shale	15	570
	SAND	14	584
	Grey shale	15	599
	Grey sdy sh	5	604
	SAND	10	614
	Grey shale	8	622
	SAND	12	634
	Grey shale Lignite	30	664
	SAND	86	750

Information upon completion of well:

- (1) Diameter: 4" x 2 1/2" inches.
- (2) Total Depth: 750 feet.
- (3) Water Level: 158 feet below top of ground.
- (4) Cased to: 699' 6" Size: 4" x 2 1/2" SWDCE
- (5) Screen: Size: .008 Length: 40'
- (6) Were any formations sealed against pollution?

15 Jts 4"	315
1 4" x 2 1/2" SWDCE	1
18 Jts 2 1/2"	379 6
1 - -	4
4. 10' 2 1/2" .008 SS Screen	699 6
1-2 1/2" Collar BPV	739 6
(Use Back Side)	770 0%

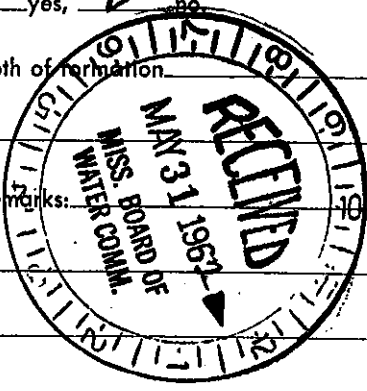

If YES depth of formation \_\_\_\_\_

Why \_\_\_\_\_

Drillers Remarks: \_\_\_\_\_