

HINDS

MISSISSIPPI BOARD OF WATER COMMISSIONERS

H-136

WATER WELL DRILLERS LOG


8-16-62

Forest Drilling

Date 7/30 to 8/16 1962, Driller: Johnnie Beasley County Hinds (Name)

(1) Owner of Land: <u>U. S. Government</u> <u>V. A. Hospital</u> (Name) <u>Jackson, Miss.</u>	Description & Color of Materials Sand, Clay, Red Clay, Shell, etc.	Thick- ness Feet	Depth Feet
This well located at same place of (2) Location: <u>1/4</u> , <u>1/4</u> , Sec <u>26 T6 R1</u> <del>and</del> other V. A. well.	<u>Silt &amp; chalk.</u>	<u>35-</u>	<u>35</u>
<u>1/4</u> miles <u>        </u> of <u>        </u> (distance) (direction) (Nearest Town)	<u>Bule clay.</u>	<u>30-</u>	<u>65</u>
(3) Topography: <u>X</u> (Hilly) (Flat) (Level)	<u>Chalk, lime &amp; shell.</u>	<u>25-</u>	<u>90</u>
(4) Purpose of Well: <u>Municipal</u> (Domestic Irrigation Municipal, Industrial, Other)	<u>Brown clay &amp; silt.</u>	<u>110-</u>	<u>200</u>
Information upon completion of well:	<u>Brown clay.</u>	<u>97-</u>	<u>297</u>
(1) Diameter <u>4</u> inches.	<u>Sand &amp; shale.</u>	<u>3-</u>	<u>300</u>
(2) Total Depth <u>743</u> feet.	<u>Fine sand.</u>	<u>24-</u>	<u>324</u>
(3) Water Level <u>220</u> feet below top of ground.	<u>Blue gumbo.</u>	<u>65-</u>	<u>389</u>
(4) Cased to <u>703'</u> , Size <u>4"</u>	<u>Blue shale.</u>	<u>36-</u>	<u>425</u>
(5) Screen: Size <u>3"</u> , Length <u>40'</u>	<u>Shale &amp; stks. rock.</u>	<u>33-</u>	<u>458</u>
(6) Were any formations sealed against pollution? <u>X</u> yes, <u>        </u> no.	<u>Fine sand.</u>	<u>17-</u>	<u>475</u>
If YES depth of formation <u>        </u>	<u>Shale.</u>	<u>6-</u>	<u>481</u>
Why <u>700'</u> of this well <del>was</del> was grouted according to specifications?	<u>Fine sand.</u>	<u>6-</u>	<u>487</u>
Drillers Remarks: <u>Good well.</u>	<u>Shale.</u>	<u>6-</u>	<u>493</u>
	<u>Shale &amp; stks. silt.</u>	<u>37-</u>	<u>530</u>
	<u>Silt &amp; lignite.</u>	<u>8-</u>	<u>538</u>
	<u>Fine sand.</u>	<u>55-</u>	<u>693</u>
	<u>Shale.</u>	<u>3-</u>	<u>696</u>
	<u>Fine sand.</u>	<u>4-</u>	<u>700</u>
	<u>Sand. (Screen setting.)</u>	<u>43-</u>	<u>743</u>

FOREST DRILLING SERVICE  
P. O. Box 5717  
PEARL BRANCH  
JACKSON 8, MISS.

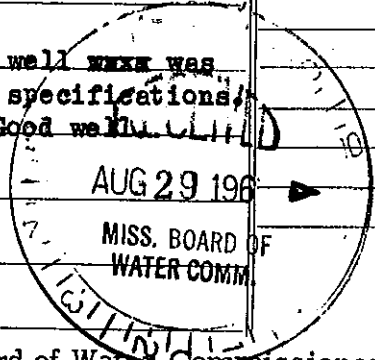

(Use Back Side)

Well No.

Mail this copy to Board of Water Commissioners 429 Miss. St. Jackson, Miss