

HINDS MISSISSIPPI BOARD OF WATER COMMISSIONERS

~~H~~ H-140

10-63

WATER WELL DRILLERS LOG

(R.G.)

Date: Oct, 1963, Driller: McNEECE DRILLING County HINDS

Eloy USGS Northgate (Name Co)

(1) Owner of Land: PRIMOS RESTUARANT (Name)

JACKSON MISS (Address)

(2) Location: NW SW 1/4, N. STATE ST, 1/4, Sec. 23 T6R1, (distance) miles IN, of JACKSON, (direction) (Nearest Town)

(3) Topography: HILLY (Hilly) (Flat) (Level)

(4) Purpose of Well: RESTUARANT (Domestic Irrigation Municipal, Industrial, Other)

Description & Color of Materials Sand, Clay, Red Clay, Shell, etc.	Thick- ness Feet	Depth Feet
SURFACE SOIL	10	10
WHITE SHALE	20	30
GREY SHALE	13	43
SHELL, SHALE & SAND	21	64
SAND & SHALE	42	106
SHALE	65	171
SAND (FINE)	85	256
SAND & SHALE	90	346
SHALE	114	460
SAND & SHALE	267	627
SAND	159	786

Information upon completion of well:

(1) Diameter 4 1/2 inches.

(2) Total Depth 786 feet.

(3) Water Level 186 feet below top of ground.

(4) Cased to 386', Size 4" 386' - 786' - 2 1/2"

(5) Screen: Size 2 1/2", Length 40'


(6) Were any formations sealed against pollution?

yes, X no.

If YES, depth of formation _____

Why _____

Drillers Remarks: _____

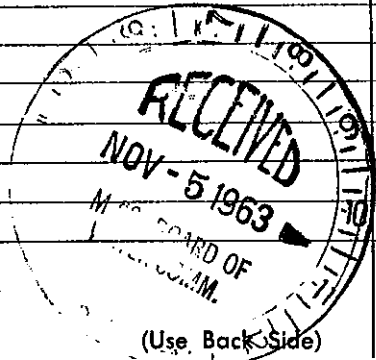

Well No. 63

Mail this copy to Board of Water Commissioners 429 Miss. St. Jackson, Miss