

HINDS
H 141
6-61

MISSISSIPPI BOARD OF WATER COMMISSIONERS

WATER WELL DRILLERS LOG

~~H 303~~
H-306

Date: JUNE, 1961, Driller: MCNEECE DRILLING Co. County HINDS

(Name)

(1) Owner of Land: <u>DIXIE WATER CO.</u> (Name)	Description & Color of Materials Sand, Clay, Red Clay, Shell, etc.	Thick- ness Feet	Depth Feet
P.O. Box 8127, JACKSON MISS (Address)	CLAY SOIL	6	0
(2) Location: <u>1/4</u> , <u>1/4</u> , Sec. <u>19 T6 R1E</u> <u>BOLING ST. JACKSON MISS</u>	YELLOW MARL	33	6
<u>1</u> miles <u>NORTH</u> , of <u>JACKSON</u> (distance) (direction) (Nearest Town)	GREY SHALE	155	39
(3) Topography: <u>HILLY</u> (Hilly) (Flat) (Level)	FINE SAND & LIGNITE	41	194
(4) Purpose of Well: <u>MUNICIPAL</u> (Domestic Irrigation Municipal, Industrial, Other)	SHALE + SAND	84	235
	FINE SAND	42	319
	SHALE	141	361
	ROCK	2	502
	SHALE	27	504
	SAND	165	538
			696


Information upon completion of well:

- (1) Diameter 6x4 inches.
- (2) Total Depth 696 feet.
- (3) Water Level 202 feet below top of ground.
- (4) Cased to 430', Size 6"
430' - 696' / 4"
- (5) Screen: Size 4", Length 60'
- (6) Were any formations sealed against pollution?
no

If YES depth of formation _____

Why _____

Drillers Remarks: _____

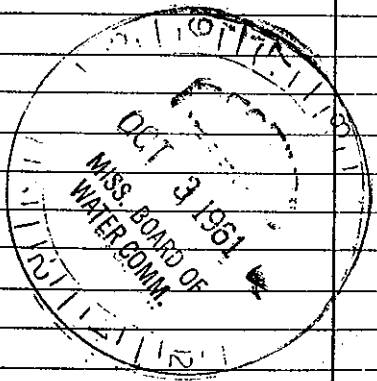

(Use Back Side)

Well No.
15

Mail this copy to Board of Water Commissioners 429 Miss. St. Jackson, Miss