

GW02144

Hinda

H-145

9-67

Elec. Log.

9/28

MISSISSIPPI BOARD OF WATER COMMISSIONERS 416 North State Street Jackson, Mississippi 39201

WATER WELL DRILLERS LOG

Date well completed

1967

Forest Drilling Hinda

firm name

county well located

LANDOWNER: Process

ENGINEERING ser.

Box 11189 - JACKSON, Miss (mailing address)

WELL LOCATION:

sec 20 T 6 N R 1 E S 5 W

1/2 miles N of JACKSON (distance) (direction) (nearest town)

WELL PURPOSE: Industrial (home, irrigation, municipal, industrial)

WELL COMPLETION DATA:

(1) diameter (inches) 6"

(2) total depth (feet) 1026'

(3) static water level (feet) 226' below top of ground.

(4) casing steel, 548' (material) (depth)

6" (size) If telescope see back.

(5) screen 40', 576' (length) (depth to top)

4", 3/4 steel (size) (material)

(6) pump 15(sub) 105 (HP) (yield gpm)

220V (type power)


(7) electric log yes (yes or no)

Miss. Acob. (organization running log)

(8) how well bottom plugged

7" F.I.B. VALVE

description of formations encountered	from	to
Clay	0	25
Blue Clay		100
Clay + silt		120
Silt + soft Clay		245
Silt + sand		255
Soft Clay + Silt		283
Clay + silt		284
Clay + silt		332
Sand + silt		390
Hard Clay		485
Rock		488
Hard Clay		500
Rock		503
Shale + silt		523
Shale + silt		530
Shale		547
Med. Sand		628

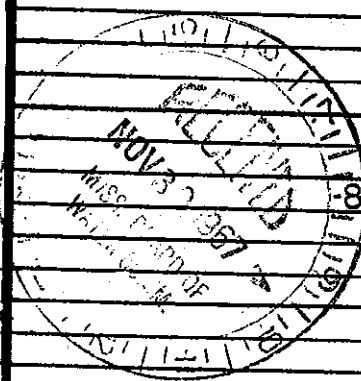

DRILLERS REMARKS:

10'-4" TAIL PIPE UNDER SCREEN -