

Hinds
 H 149
 B-67
 Elec Log


MISSISSIPPI
 BOARD OF WATER COMMISSIONERS
 416 North State Street
 Jackson, Mississippi 39201

LC 472

WATER WELL DRILLERS LOG

8-31-1967 date well completed
 Layne Central Company firm name
 Hinds county well located

LANDOWNER:	description of formations encountered	from	to
Metropolitan Water, Inc. Jackson, Miss. (mailing address)			
WELL LOCATION: Bradley Road sec. 7 T. 6 N. R. 1 E 11 S W	Yellow Clay	5	15
	Yazoo Clay	15	220
WELL PURPOSE: Domestic (home, irrigation, municipal, industrial)	Beard Shale	220	280
	Clay	280	330
WELL COMPLETION DATA:	Shale	330	396
	Shale + Sand strks.	396	525
(1) diameter (inches) 16"	Sandy Clay	525	565
(2) total depth (feet) 693'	lime (Hard)	565	570
(3) static water level (feet) 180' below top of ground.	Shale + Hard strks.	570	597
(4) casing steel, 622' (material), (depth)	Sand	597	685
16" (size) if telescope see back.	Sand + Shale strks.	685	755
(5) screen 60' (length), 627' (depth to top)	Sand	755	763
8" (size), Stainless Steel (material)	Sand + Shale strks.	763	772
(6) pump 125 (HP), (yield gpm)	Clay	772	821
Elec (type power)	Sandy Shale	821	853
(7) electric log YES (yes or no)	Packed Sand	853	918
Schlumberger (organization running log)	Shale	918	920
(8) how well bottom plugged Valve	Sand	920	932
	Shale + Sand strks.	932	986
	FINE Sand	986	990
	Shale	990	1006
	Sand + Shale strks	1006	1027
	Shale + strks. sand	1027	1037
	Shale + strks. Rock	1037	1077
	Rock	1077	1078
	Shale	1078	1124

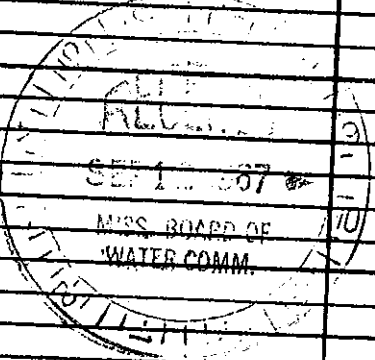

DRILLERS REMARKS:
 Pump not set as of this date
 No test has been run